

REV. #	DESCRIPTION	DATE
1	REDLINE REVISIONS	2-25-21
2	REDLINE REVISIONS	2-26-21
3	REDLINE REVISIONS	3-5-21
4	REDLINE REVISIONS	4-12-21
5	REDLINE REVISIONS	5-9-21
6	REDLINE REVISIONS	5-17-21


MODEL:	CUSTOM
DRAWN BY:	JAT
DWG DATE:	11/13/20
24x36 SHEET	
0 2' 4' 8'	
SCALE: 1/4" = 1'-0"	
SHEET TITLE:	FIRST FLOOR PLAN
SHEET:	A-210

PROFESSIONAL CERTIFICATION



"Professional Certification. I hereby certify that these documents were prepared or approved by me, and that I am a duly licensed professional engineer under the laws of the State of Maryland, License No. 15453, Expiration Date: July 2, 2023."

GEOFFREY A. TIZARD, II, P.E.
 5 LEADBURN COURT
 TOWSON, MARYLAND 21204

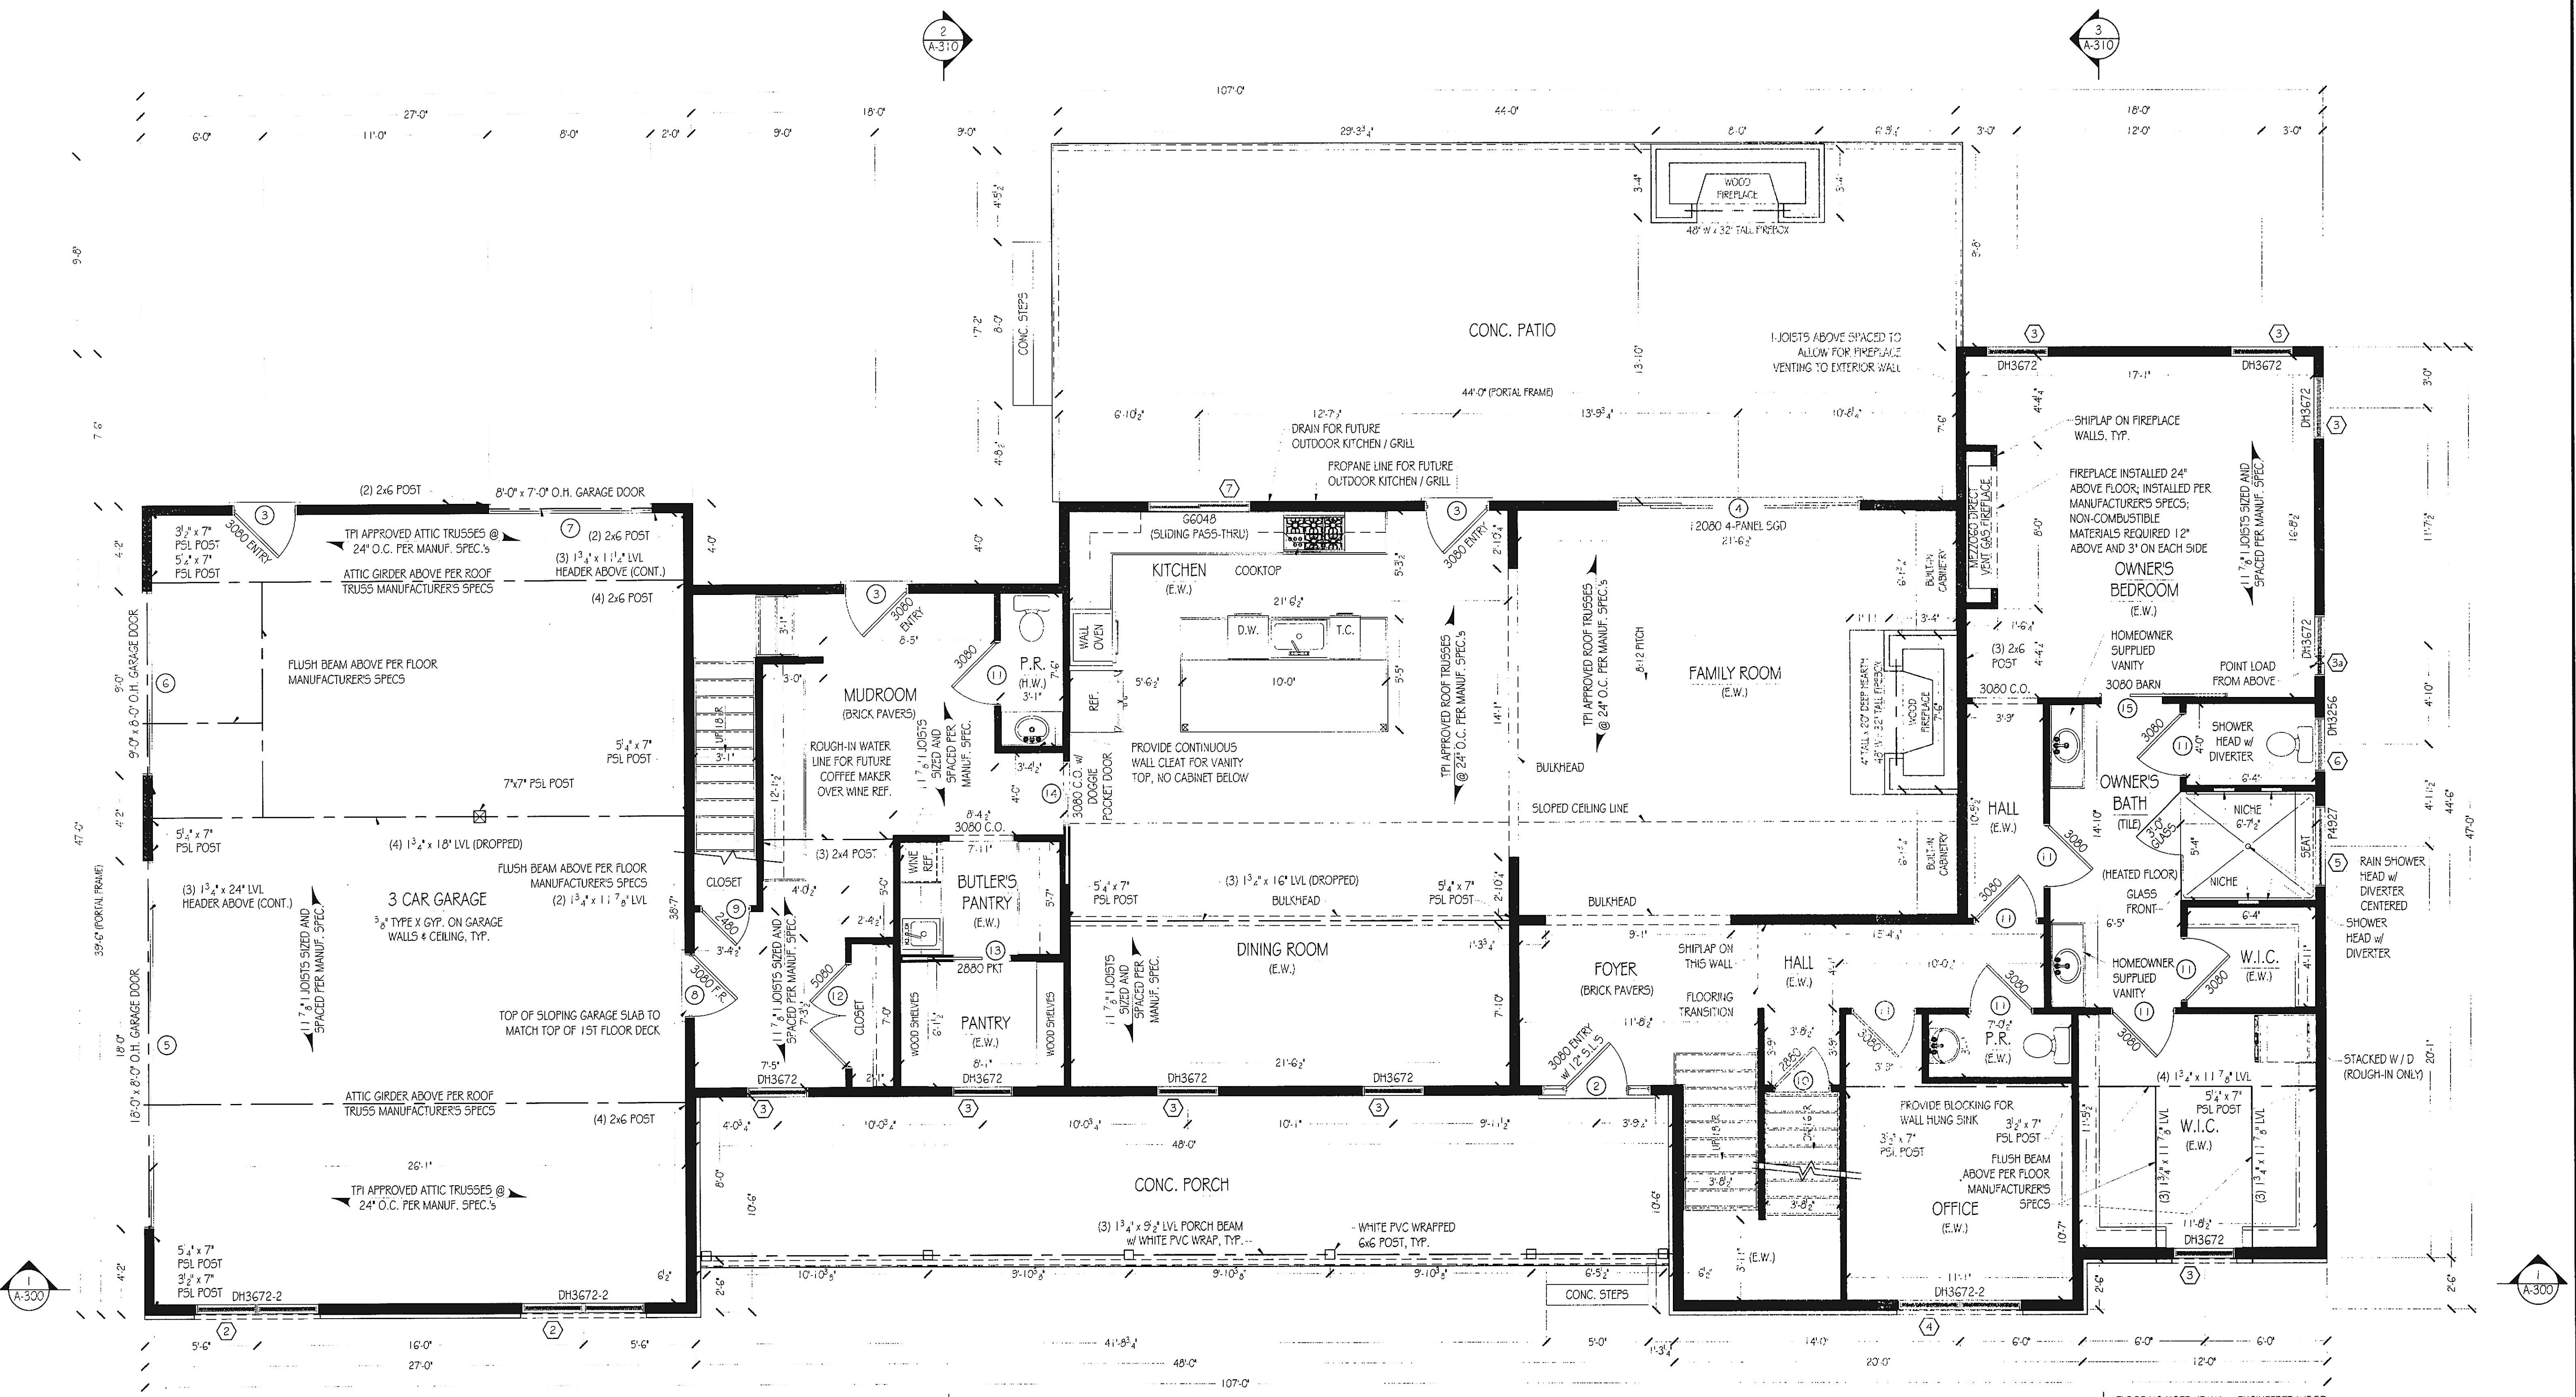

FIRST FLOOR PLAN
 SCALE: 1/4" = 1'-0"

FLOORING NOTE: (E.W.) = ENGINEERED WOOD