


NOTES:
REF: SK# 09-2041

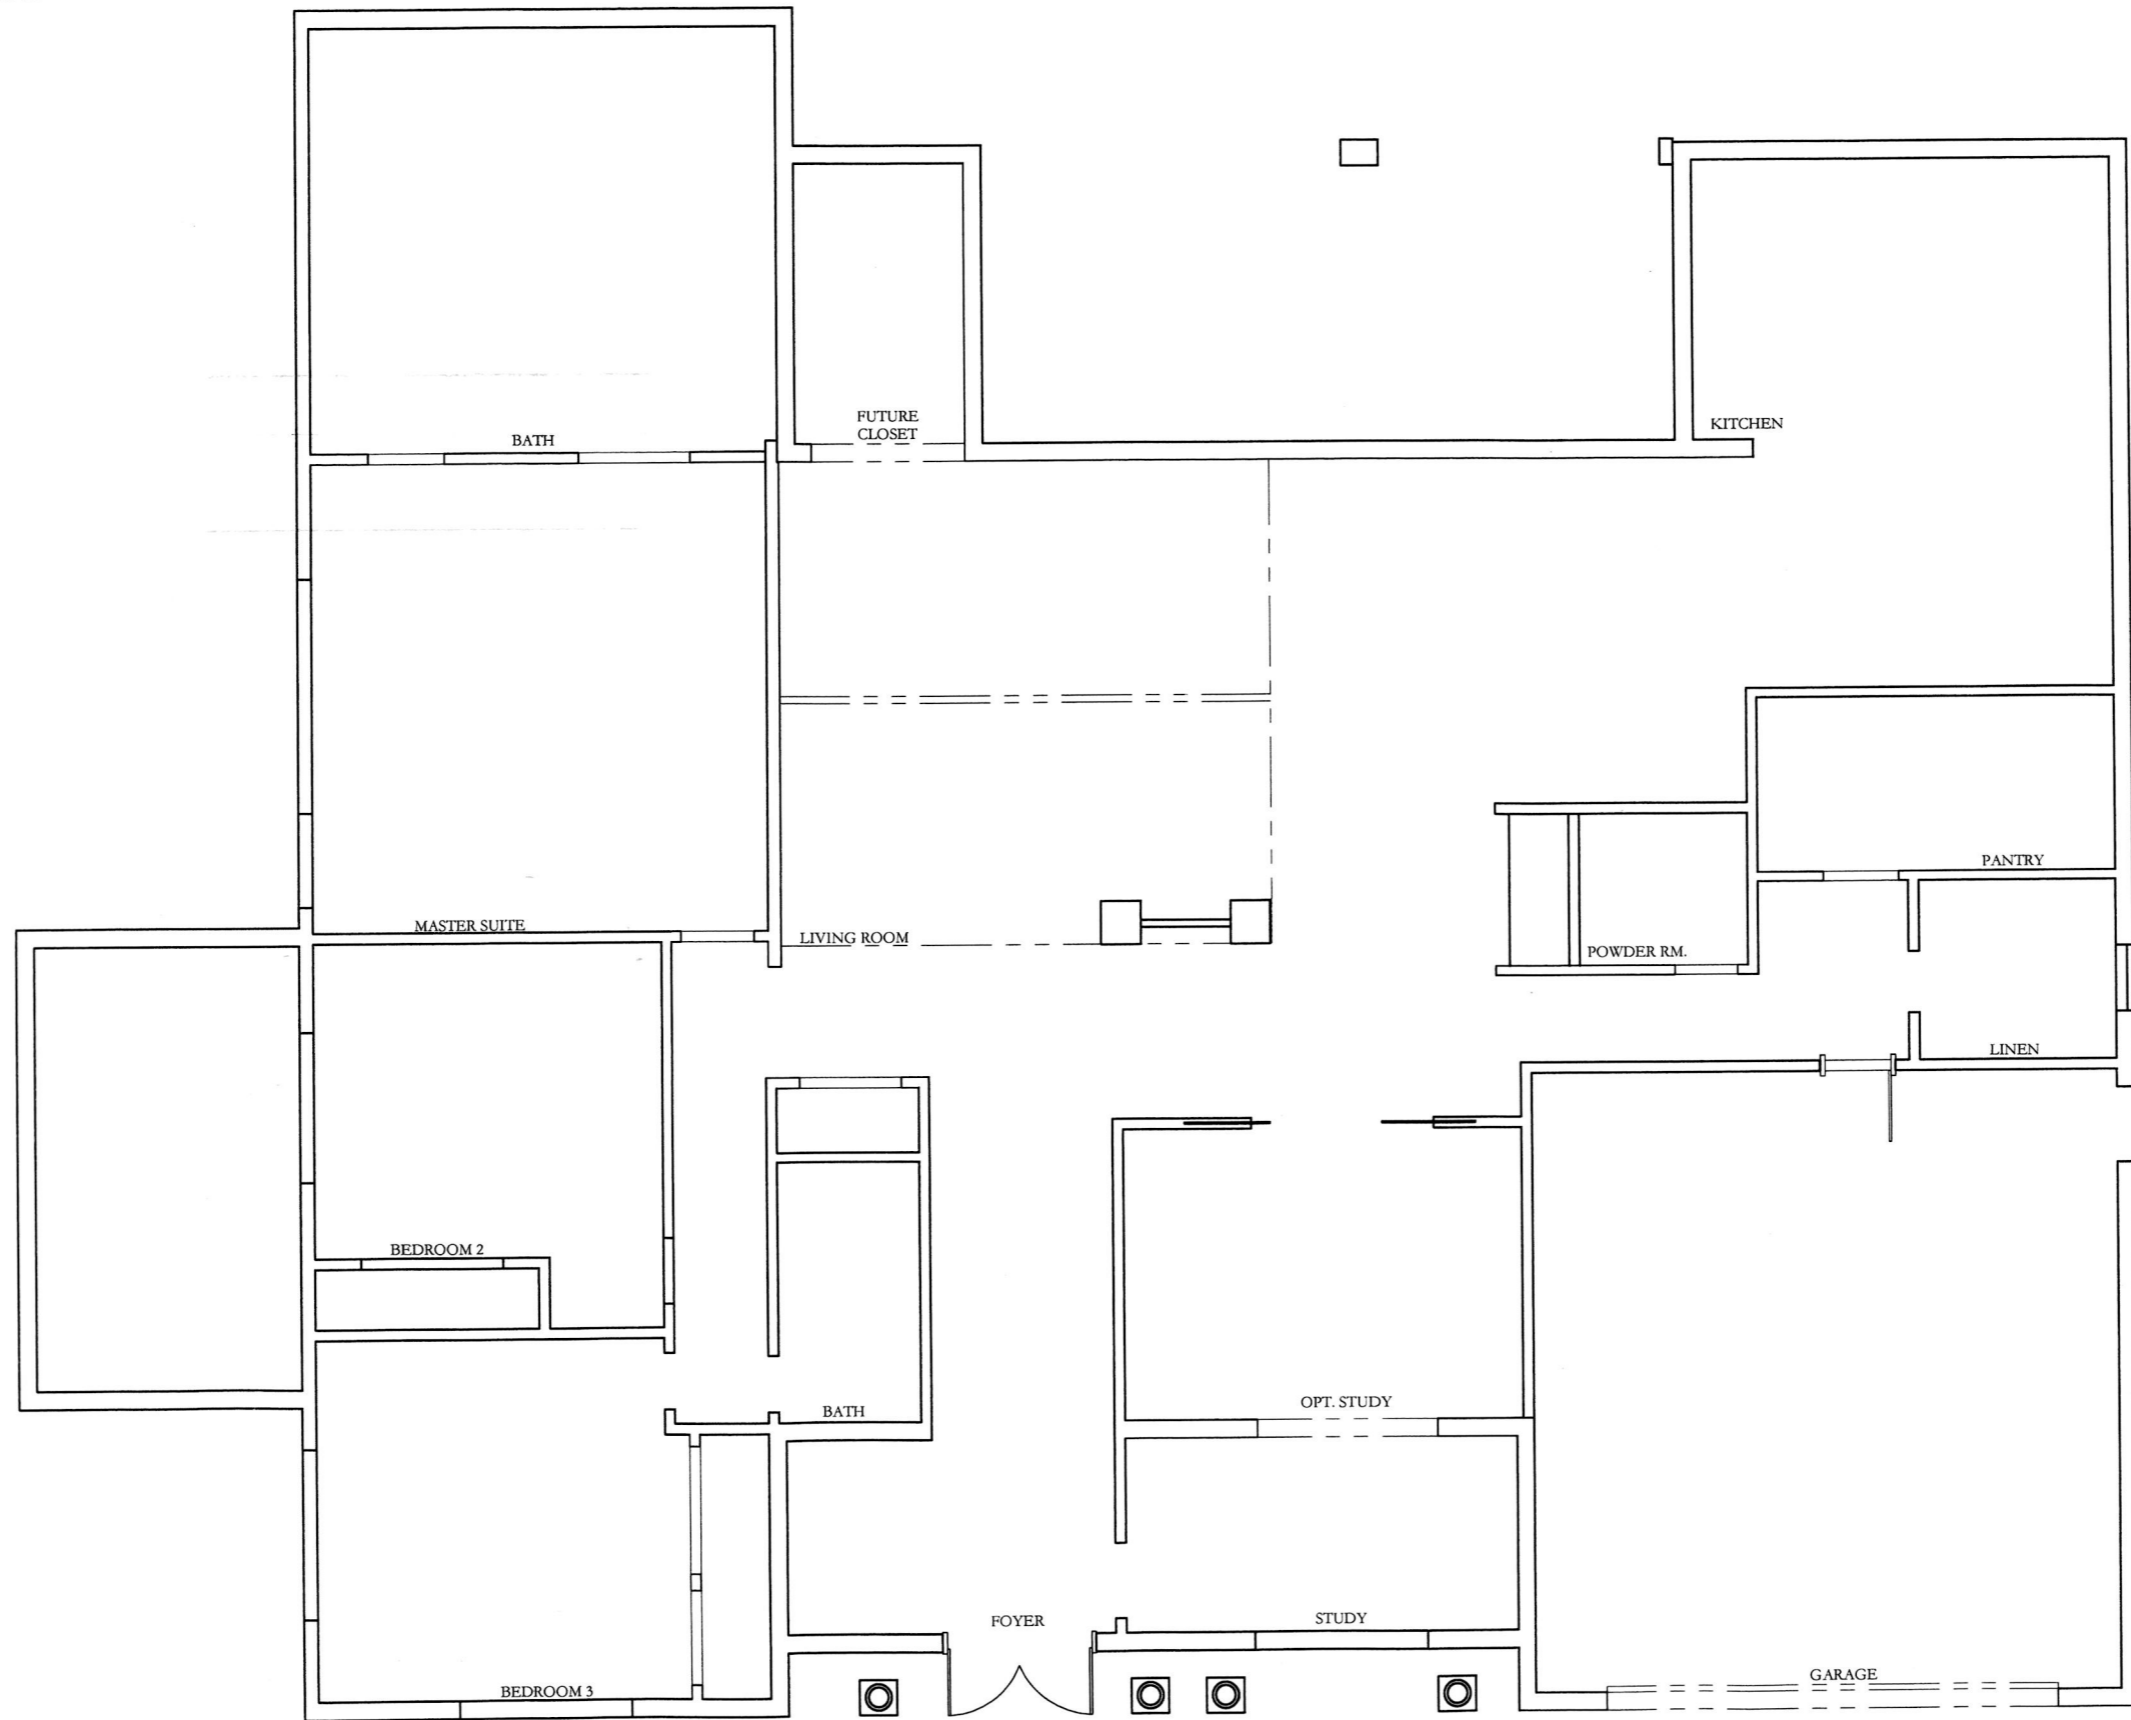

SCALE: 1/4" = 10"

AS-BUILT
S. Bondrea
7/18/21