


**FLOOR PLAN-EXISTING CONDITIONS/  
NEW WORK (EXHAUST)**  
SCALE: 1/4"=1'-0"

**DRAWING NOTES**

- ① OUTLINE OF EXHAUST FAN MOUNTED ON ROOF. REFER TO SHEET M-105.00 FOR SIZE AND CAPACITY. PRIOR TO INSTALLING THE ROOF MOUNTED EXHAUST FAN THE MECHANICAL CONTRACTOR MUST COORDINATE THE EXACT MOUNTING LOCATION WITH THE BUILDING OWNER.
- ② EXTEND A 14"x14" EXHAUST AIR DUCTWORK PLENUM BOX DOWN ±24" BELOW ROOF LINE AND UP THROUGH EXISTING ROOF TO ROOF MOUNTED EXHAUST FAN. TRANSITION DUCTWORK AS REQUIRED TO UNIT'S CONNECTION. PROVIDE FLEXIBLE CONNECTION AT DUCTWORK CONNECTION TO UNIT.
- ③ CEILING MOUNTED VENTILATION FAN SUPPORTED FROM STRUCTURE ABOVE. DISCHARGE INTO PLENUM. REFER TO SHEET M-105.00 FOR SIZE AND CAPACITY.
- ④ EXHAUST AIR DUCTWORK SUPPORTED ABOVE THE CEILING/TIGHT TO STRUCTURE (TYPICAL).
- ⑤ EXHAUST AIR GRILLE MOUNTED IN DRYWALL CEILING WITH NECK SIZE AND AIR VOLUME INDICATED (TYPICAL).
- ⑥ EXHAUST AIR GRILLE MOUNTED WITHIN ACOUSTICAL CEILING TILE WITH NECK SIZE AND AIR VOLUME INDICATED (TYPICAL).
- ⑦ VOLUME DAMPER (TYPICAL).
- ⑧ 1" DOOR UNDERCUT BY OTHERS (TYPICAL).
- ⑨ REVERSE ACTING THERMOSTAT TO BE MOUNTED ±48" ABOVE FINISHED FLOOR ON WALL TO CONTROL VENTILATION FAN.
- ⑩ DUCTWORK SUSPENDED FROM MEZZANINE STRUCTURE/ABOVE THE CEILING.
- ⑪ INSTALL A FIRE DAMPER IN DUCTWORK ABOVE THE CEILING. CLEARLY/NEATLY IDENTIFY ON THE CEILING GRID WITH 1/4" HIGH LETTERS JUST BELOW FIRE DAMPER.
- ⑫ 12"x12" PERFORATED AIR DEVICE WITH RADIATION FIRE DAMPER MOUNTED IN DRYWALL CEILING WITH NECK SIZE DUCT CONNECTION ABOVE CEILING.
- ⑬ ROUTE DUCTWORK DOWN TO BE SUPPORTED BELOW THE MEZZANINE.

This project was designed in 2013 and was originally signed and sealed and submitted for permit on or about 8/20/13. The stamp below with the current date is to document that this is a record copy of those drawings. These represent no new work done after the construction done based on these drawings and this is ONLY certifying the design work done in 2013

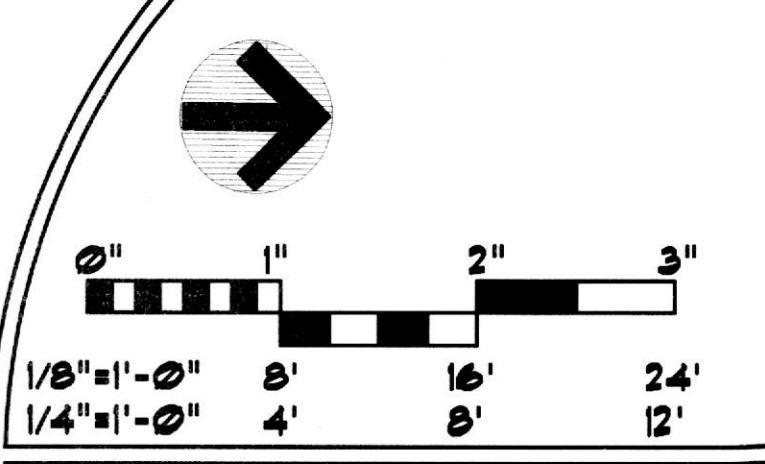


**ISSUED FOR  
BUILDING PERMIT**

To the best of my knowledge, belief and professional judgement, these plans and specifications, are in compliance with Section 101.4.4 of the New York City Energy Conservation Code (NYCECC).

**Richard J. Stern, P.E.**  
2741 Furnace Road  
Felton, PA 17322  
Phone: 717-891-6026

TENANT RENOVATIONS FOR:  
**Access Center**  
1733 Eastchester Road  
Bronx, NY 10461

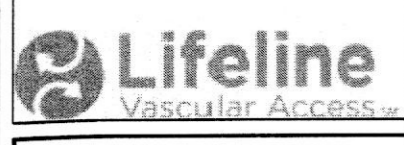

**InSync**  
ARCHITECTURAL DESIGNS, INC.  
1215 Old Pylesville Road Whiteford, MD 21160  
Office: 410-452-8006 Fax: 410-452-8046



**FLOOR PLAN-NEW WORK (EXHAUST)**

REVISIONS		DRAWING NO. M-103.00
REV#	DATE	
1	7/16/13	OWNER'S REVISION

SHEET 3 OF 9  
DATE 4/18/13  
DRAWN BY DLI  
CHECKED BY DLI  
DATE 11/20/13  
DESIGNED BY DLI  
SDI# 2013-01H