




ROOFTOP UNIT CONDENSATE TRAP DETAIL
NO SCALE

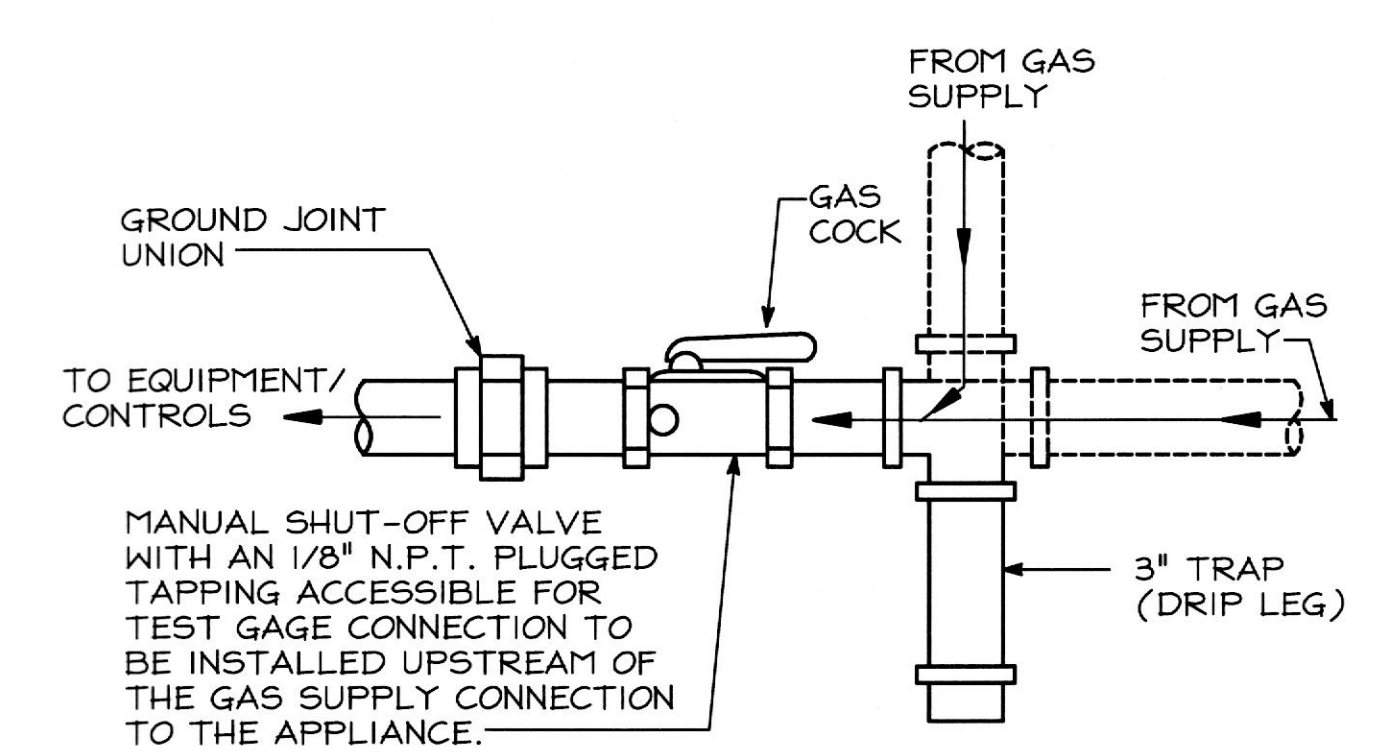


GAS CONNECTION DETAIL
NO SCALE

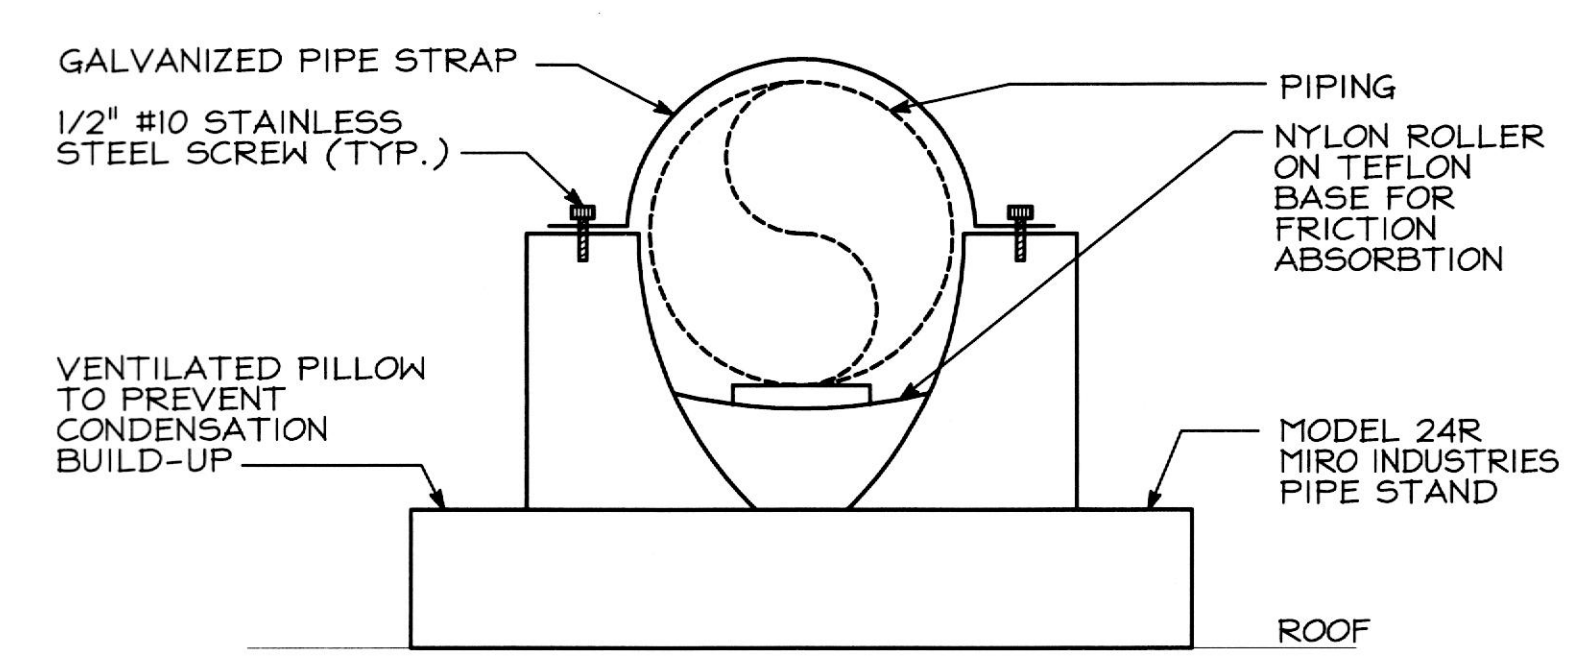


PILLOW BLOCK PIPESTAND DETAIL
NO SCALE

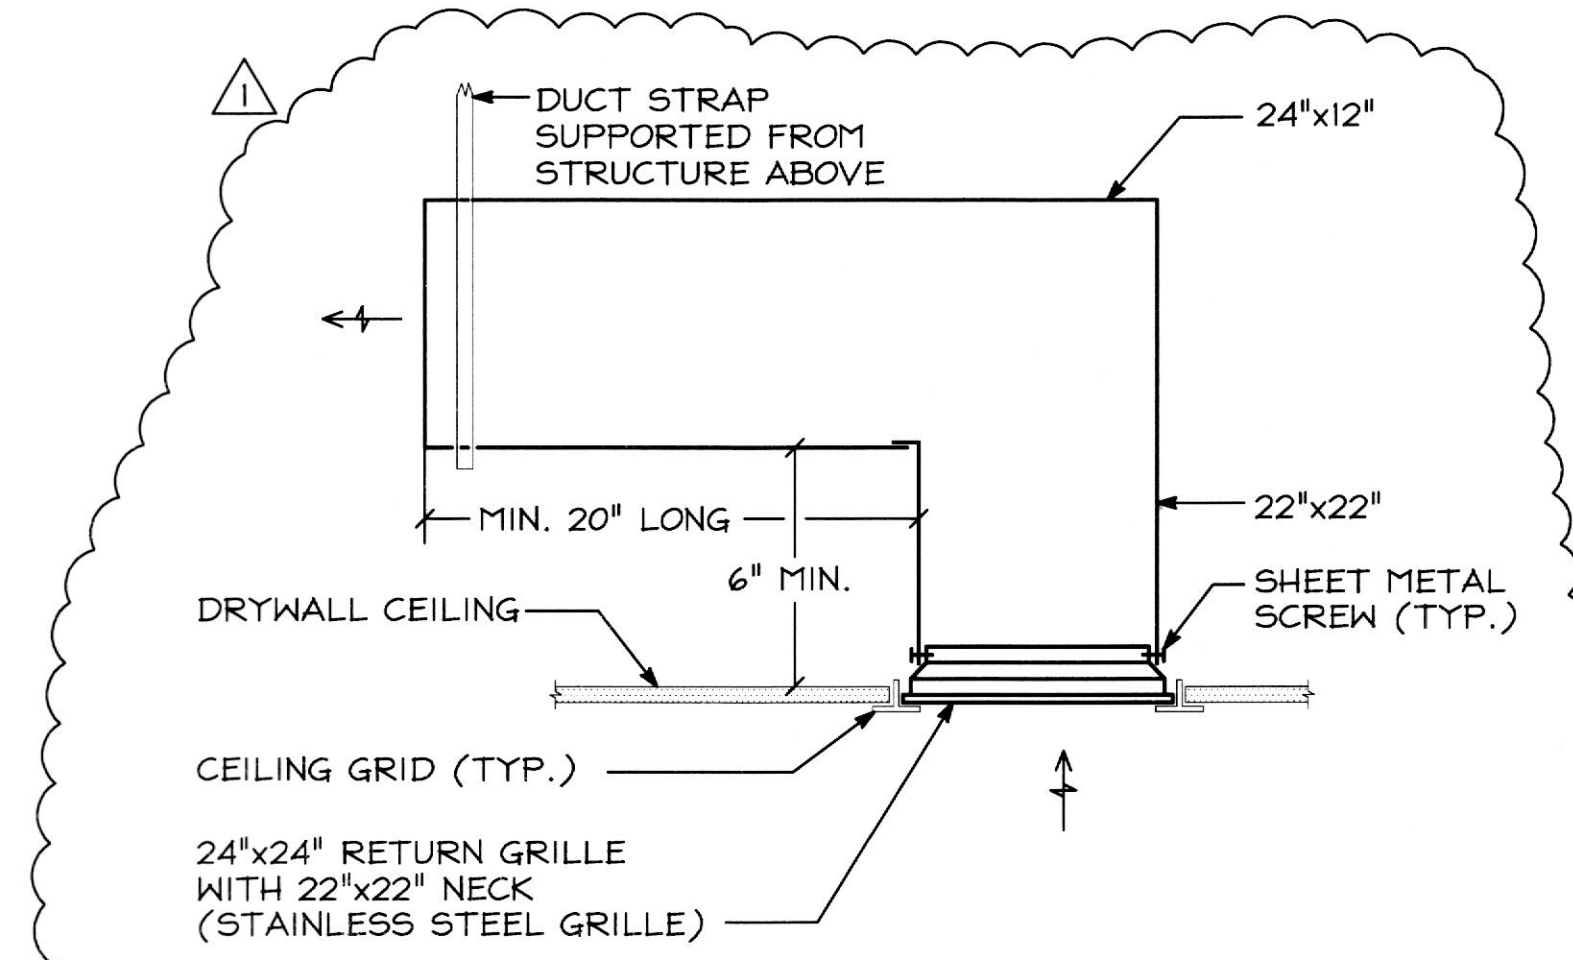


AIR TRANSFER ASSEMBLY DETAIL
NO SCALE
NOTE:
1) PROVIDE 1/2"x1/2" WIRE MESH SCREEN ON DUCT OPENING.

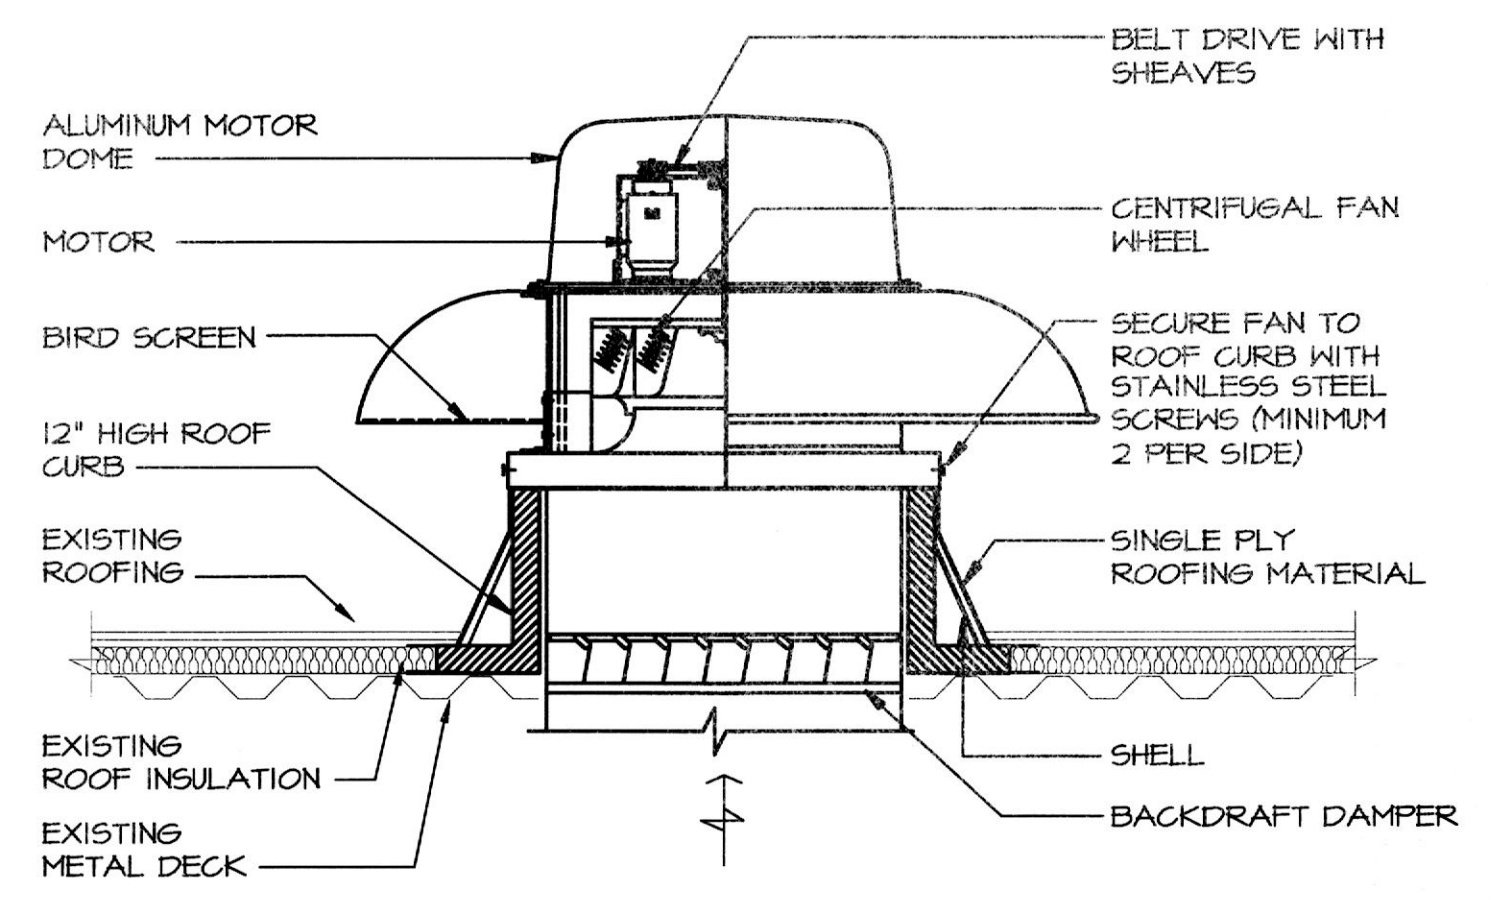


ROOF MOUNTED EXHAUST FAN DETAIL
NO SCALE

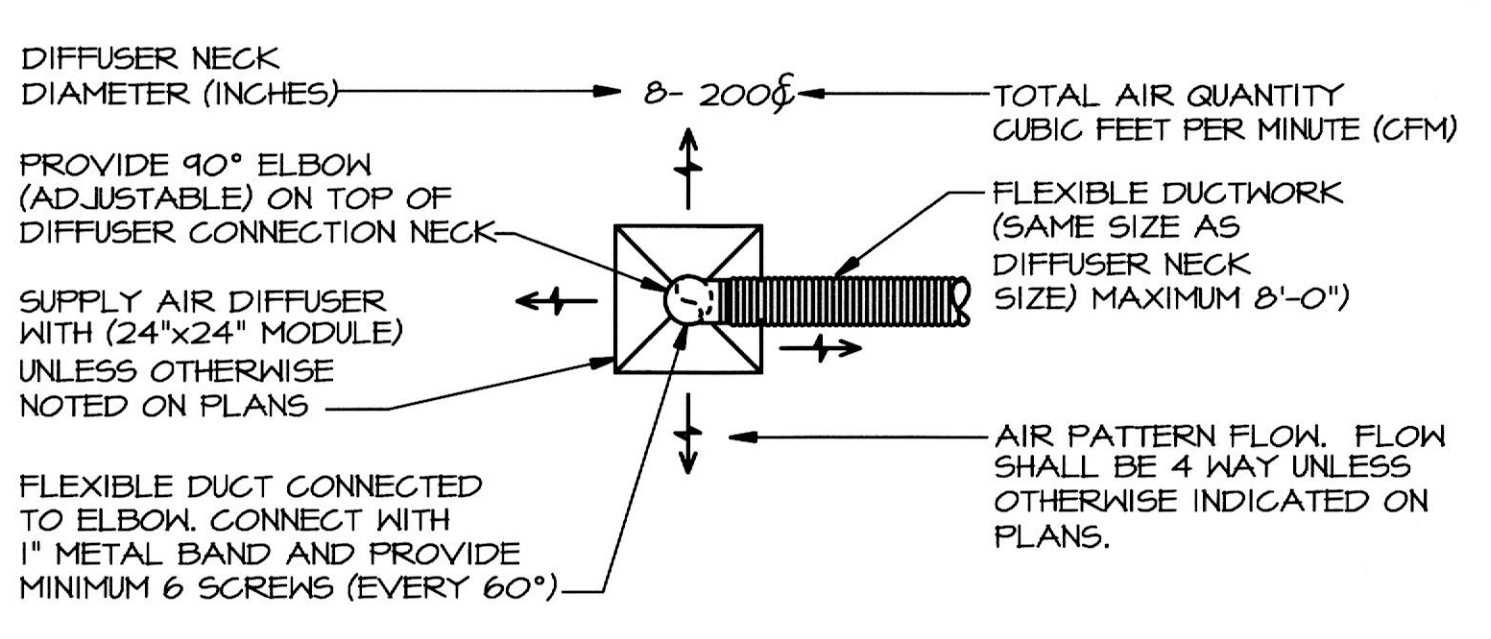

SUPPLY AIR DIFFUSER KEY
NO SCALE

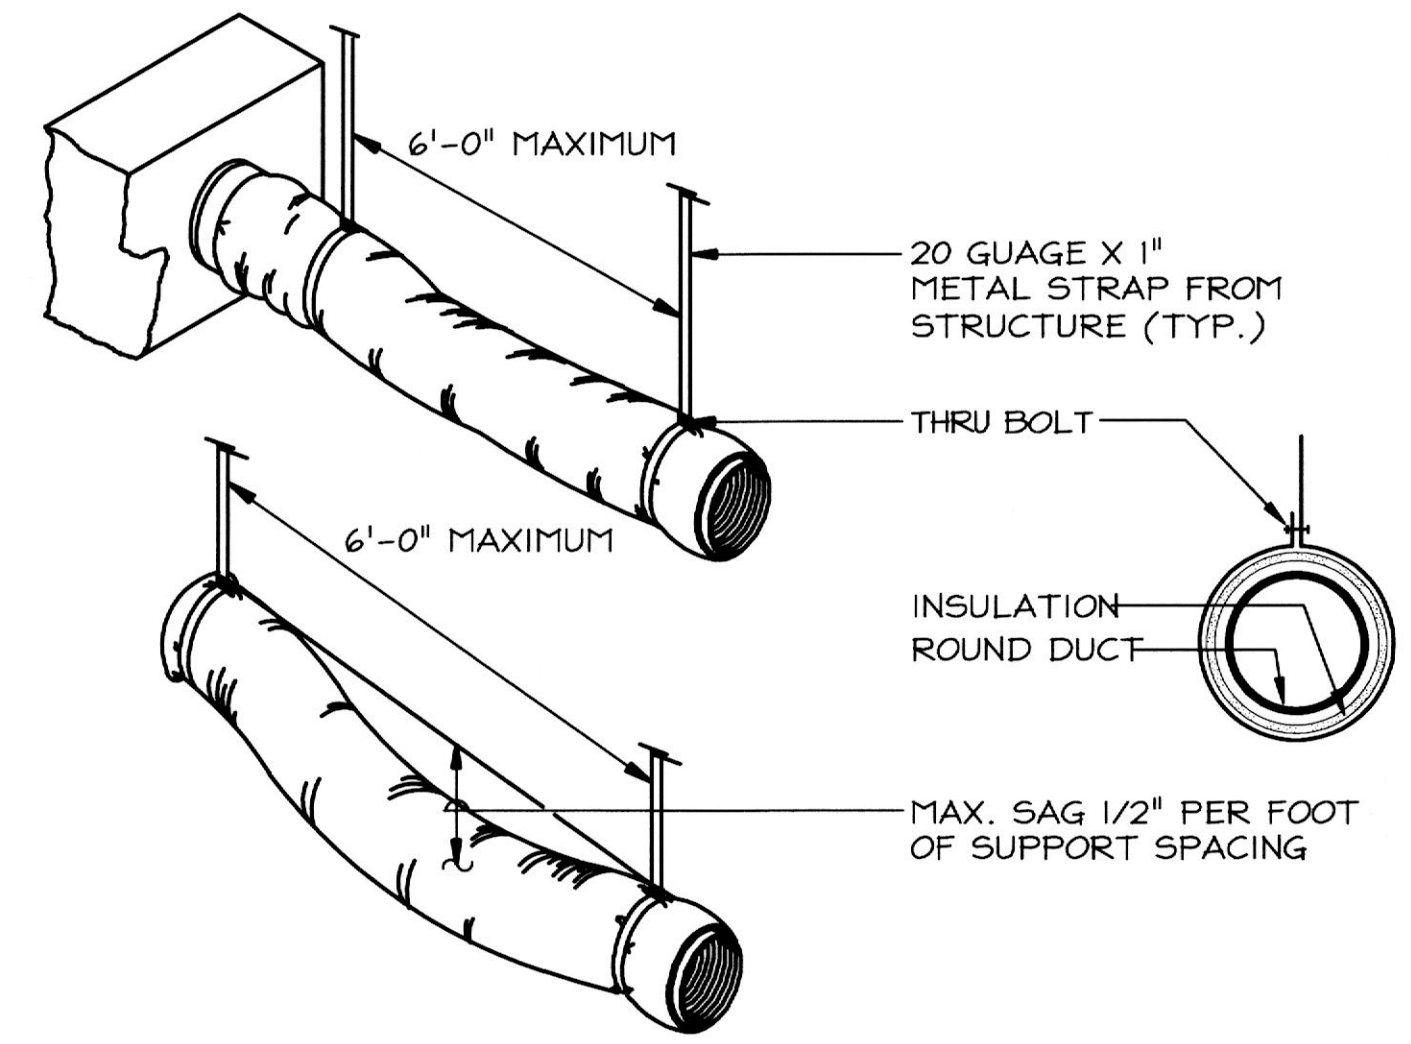

FLEXIBLE DUCT RUN-OUT SUPPORT DETAIL
NO SCALE

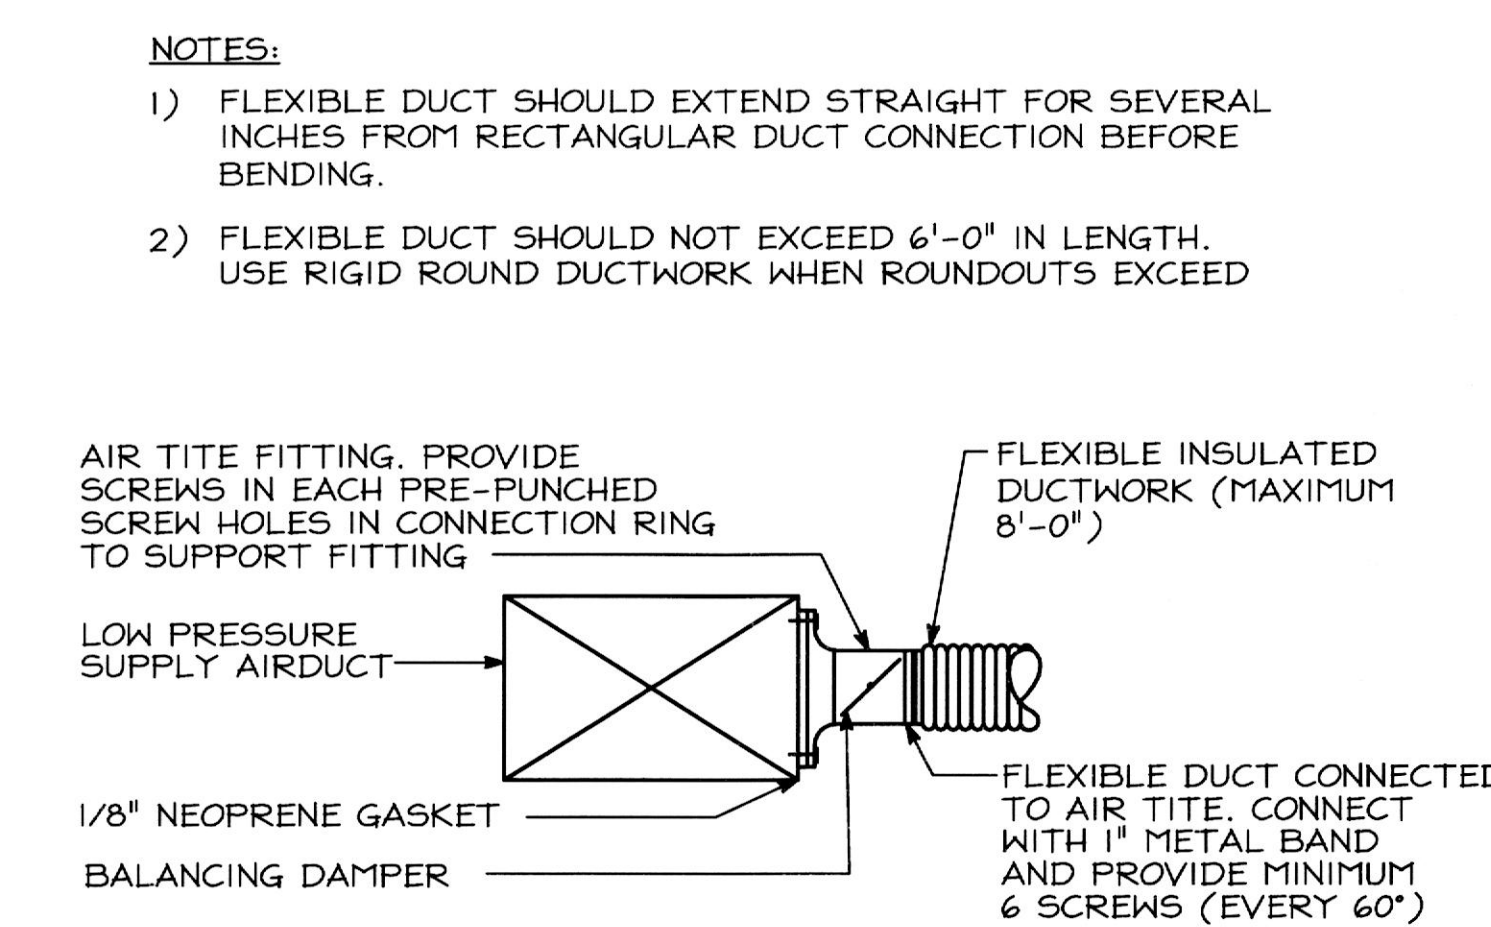


AIR TITE FITTING DETAIL
NO SCALE

AIR TITE SIZE CHART


DUCTSIZE	CONNECTION RING	DUCTSIZE	CONNECTION RING
5"	8"	9"	12"
6"	9"	10"	13"
7"	10"	11"	14"
8"	11"	12"	15"

NOTE:
1) WHERE CONNECTION RING SIZE IS LARGER THAN SUPPLY DUCT, THEN CONNECTION RING SHALL BE CRIMPED OVER DUCT AND CONNECTED, SCREWED AND SEALED ON TOP AND BOTTOM OF SUPPLY DUCT.

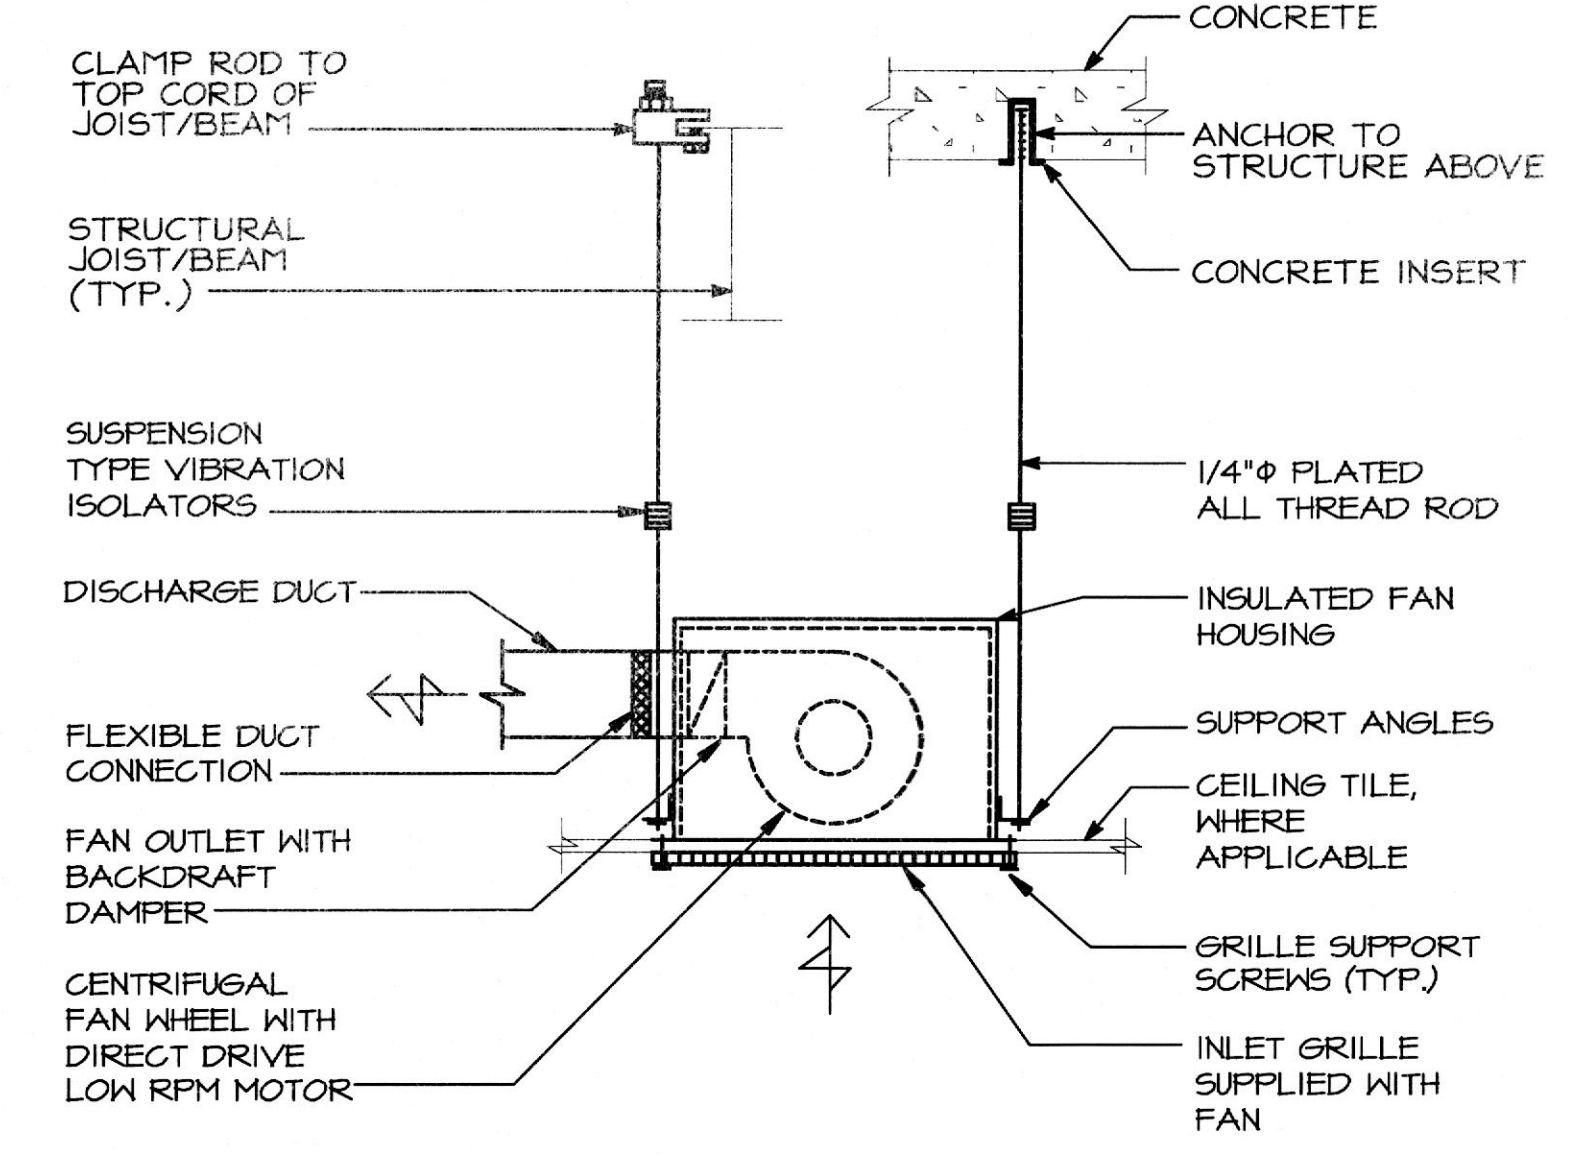

CEILING MOUNTED EXHAUST FAN DETAIL
NO SCALE

NOTE:
1) PROVIDE VARIABLE SPEED SWITCH ON THE SIDE OF THE CASING FOR FINAL AIR BALANCE.

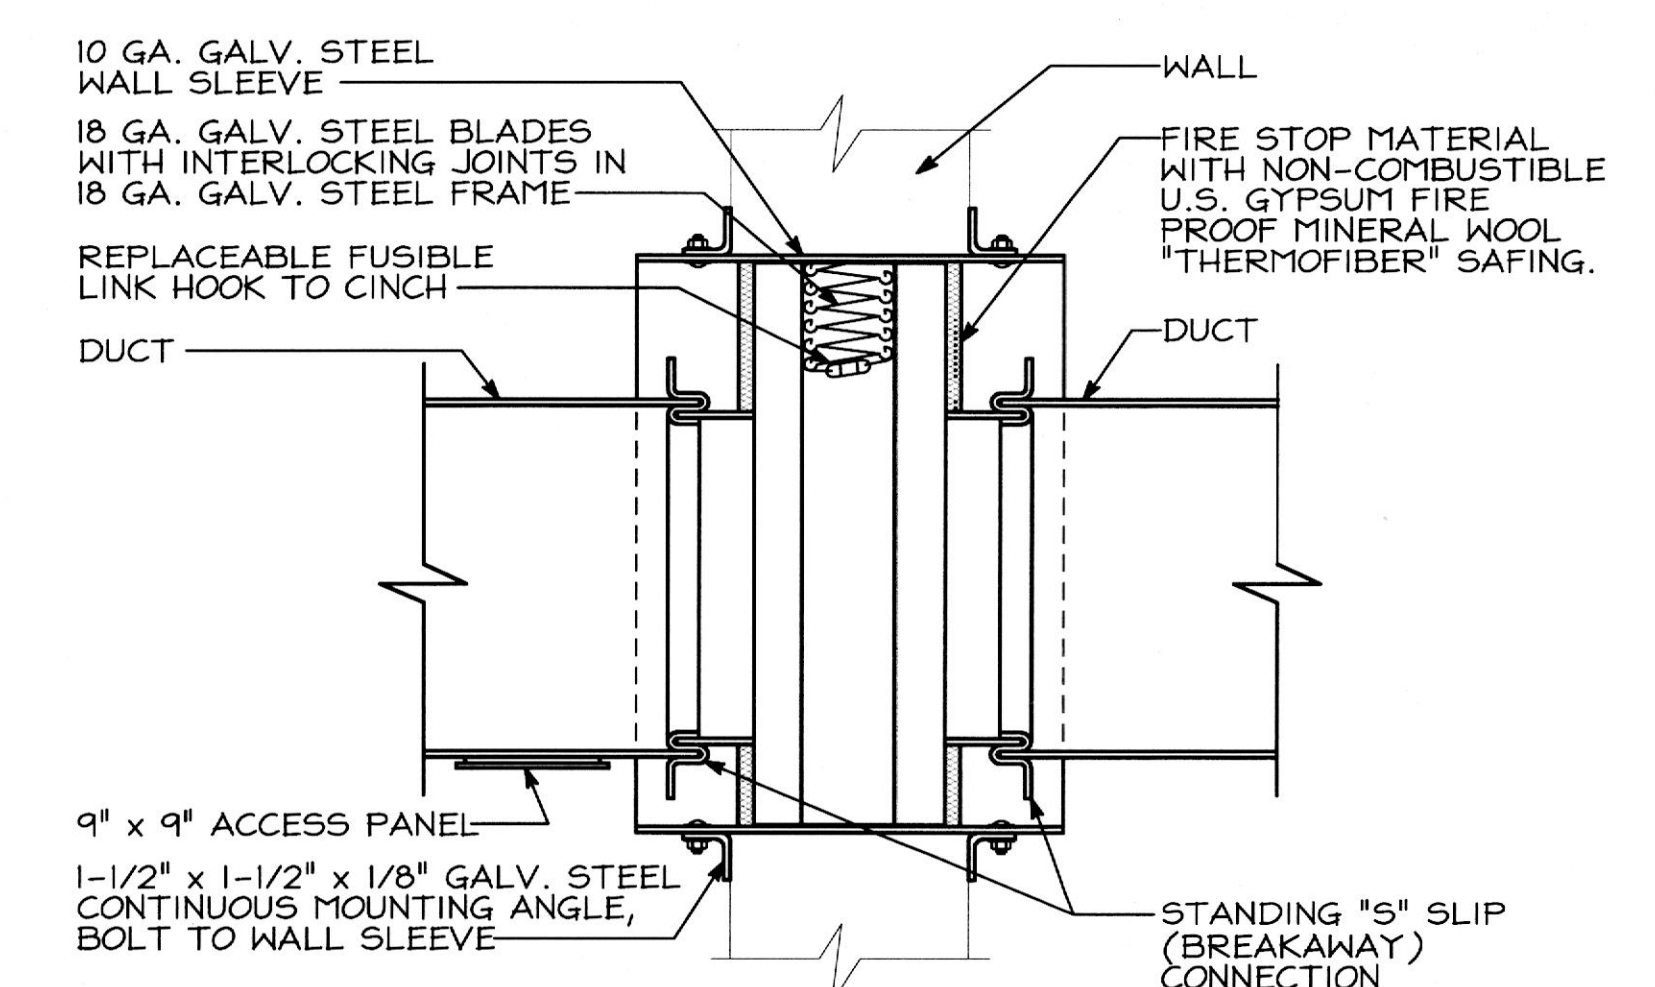

HORIZONTAL DUCT FIRE DAMPER DETAIL
NO SCALE

NOTES:
1. FIRE DAMPERS TO HAVE BREAKAWAY JOINT BETWEEN COLLARS AND DUCT. (COLLARS SHALL BE INTEGRAL WITH FIRE DAMPERS FRAME.)
2. FIRE DAMPER SHALL BE U.L. LABELED.
3. ACCESS PANELS ARE REQUIRED FOR EVERY FIRE DAMPER LOCATION. THIS MUST BE CLEARLY/NEATLY IDENTIFY ON THE CEILING GRID WITH 1/2" HIGH LETTERS JUST BELOW EACH FIRE DAMPER ACCESS PANEL.

ISSUED FOR BUILDING PERMIT

To the best of my knowledge, belief and professional judgement, these plans and specifications, are in compliance with Section 101.4.4 of the New York City Energy Conservation Code (NYCECC).

Richard J. Stern, P.E.


2741 Furnace Road
Fulton, PA 17322
Phone: 717-891-6026

TENANT RENOVATIONS FOR:
Access Center
1733 Eastchester Road
Bronx, NY 10461

Lifeline
Vascular Access

InSync
ARCHITECTURAL DESIGNS, INC.
1219 Old Pylesville Road Whiteford, MD 21160
Office 410-452-8006 Fax 410-452-8046

This project was designed in 2013 and was originally signed and sealed and submitted for permit on or about 8/20/13. The stamp below with the current date is to document that this is a record copy of those drawings. These represent no new work done after the construction done based on these drawings and this is ONLY certifying the design work done in 2013.

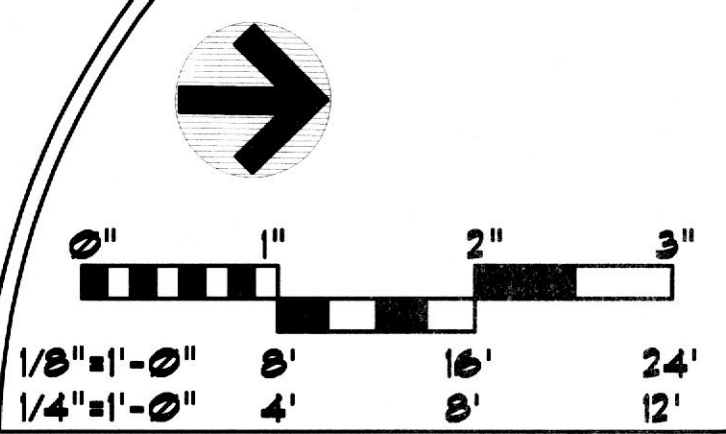

DETAILS

REV#	DATE	REVISIONS DESCRIPTION
1	7/16/13	OWNER'S REVISION

DRAWING NO. M-104.00
SHEET 4 OF 9
DATE 4/10/13 DRAWN BY DLI
JOB NUMBER 11206 CHECKED BY DLI
SD# 2013-01H