DEMOLITION NOTES:

1. REMOVE EXISTING DOOR. INCLUDE DOOR, FRAME AND HARDWARE.
2. REMOVE EXISTING DOOR / WINDOW. INCLUDE DOOR, FRAME AND HARDWARE. IN-FILL EXISTING OPENING TO MATCH SURROUNDING WALL.
3. REMOVE EXISTING DOOR AND RE-SWING.
4. REMOVE EXISTING DOOR AND WINDOW. IN-FILL OPENING OF DOOR UP TO EXISTING WINDOW SILL. INSTALL "NEW" WINDOW TO MATCH EXISTING
5. REMOVE EXISTING WINDOW AND WALL BELOW AND ABOVE OPENING.
6. REMOVE EXISTING WALL FULL HEIGHT. INCLUDE GWB, STUDS, ELECTRICAL AND PLUMBING WITHIN WALL. SHORE UNTIL NEW WALL FRAMING IS PLACED - SEE A1.1
7. REMOVE EXISTING STORAGE CHICKEN WIRE CAGES.
8. REMOVE PORTION OF EXISTING WALL FOR "NEW" PASS THRU OPENING. SEE NEW WORK PLAN A1.1 FOR SIZE AND LOCATION.
9. REMOVE PORTION OF EXISTING WALL FOR "NEW" DOOR OPENING.
10. REMOVE EXISTING BEAUTY SHOP EQUIPMENT. INCLUDE SINKS, COUNTERS, DRYERS AND CABINETS.
11. REMOVE EXISTING FLOORING, SCRAPE, GRIND, PATCH AND LEVEL FOR "NEW" FLOORING.
12. REMOVE EXISTING HANDRAIL.
13. REMOVE EXISTING PLUMBING AND PIPING.
14. REMOVE EXISTING GRAB BARS AND BATHROOM ACCESSORIES.
15. REMOVE EXISTING COUNTERS AND CABINETS, INCLUDING APPLIANCES AND PLUMBING FIXTURES. CAP PLUMBING WITHIN WALL OR UNDER FLOOR SLAB. PATCH WALLS AND FLOOR AS REQUIRED TO MATCH SURROUNDING SURFACES.
16. RELOCATE EXISTING CONDENSERS. SEE MECHANICAL DRAWINGS FOR "NEW" LOCATIONS
17. REMOVE EXISTING SIDEWALK AND PATIO
18. RELOCATE EXISTING FIRE EXTINGUISHER CABINET. SEE NEW WORK PLAN FOR LOCATION
19. REMOVE EXISTING BRICK. PREP FOR "NEW" GWB AND FINISH.
20. REMOVE EXISTING CEILING MOUNTED CUBICLE CURTAIN TRACK
21. REMOVE PORTION OF EXISTING WALL FOR INSTALL OF "NEW" DRYER
22. REMOVE PORTION OF EXISTING CONCRETE STAIR WALL
23. REMOVE EXISTING WINDOW AND REPLACE WITH "NEW" WINDOW WITH 45 MIN. PYROSTOP GLAZING

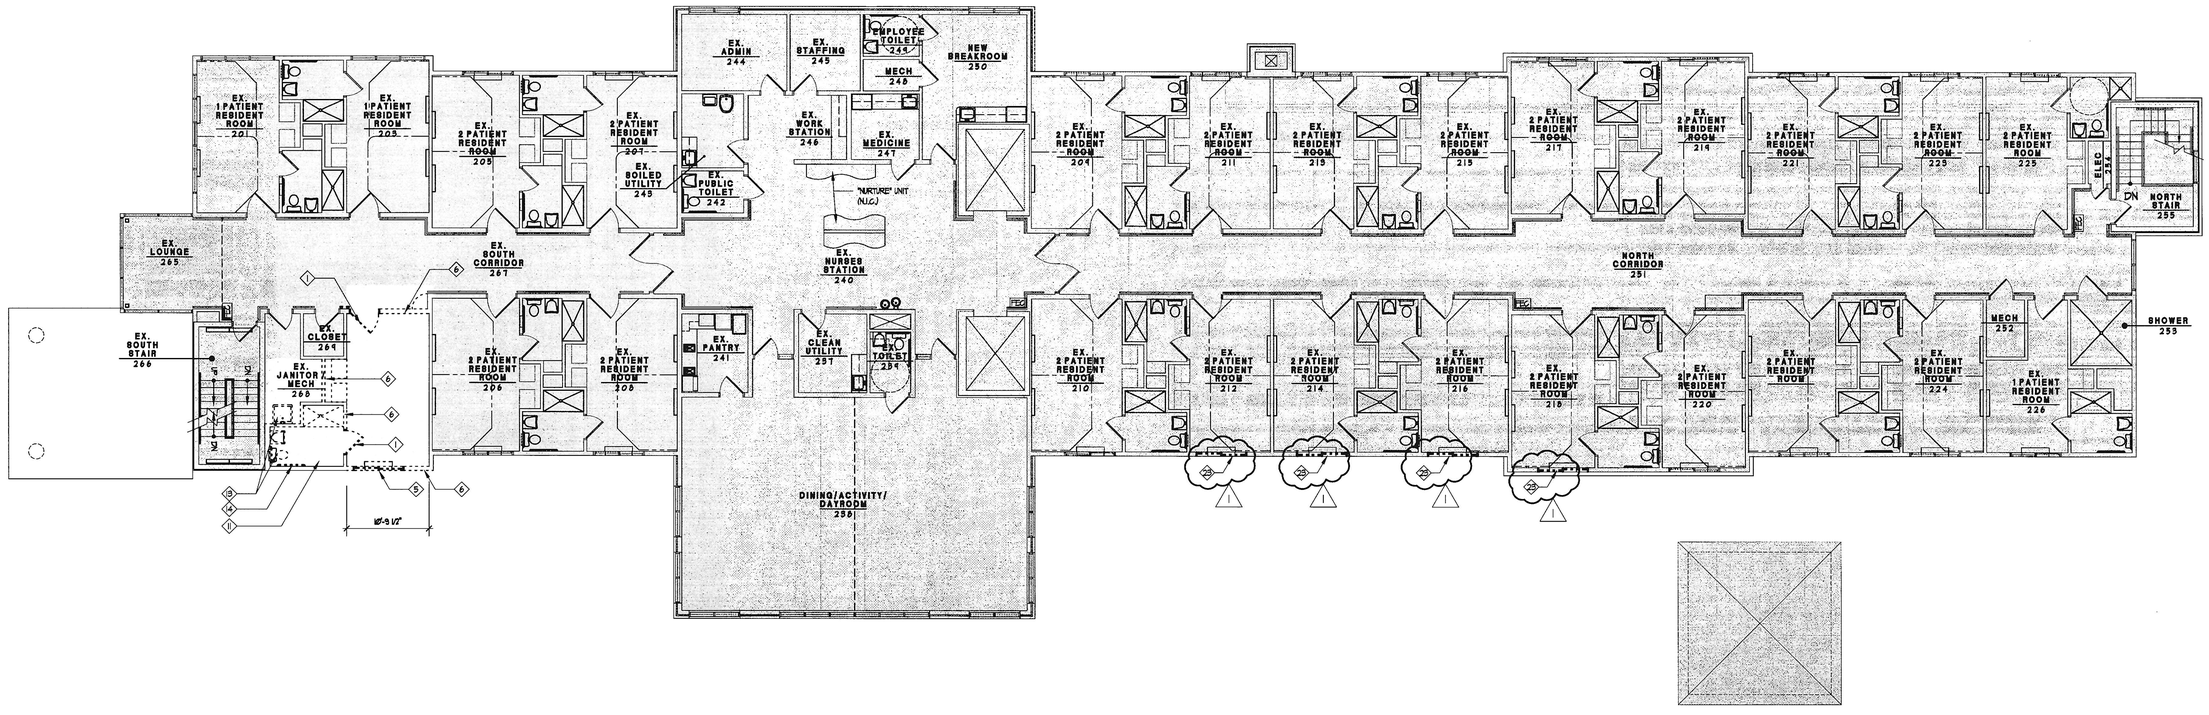

DRAWING NOTES:

EXISTING - NO WORK

EXISTING - RENOVATION

N

0 4' 8' 16'

SCALE: 1/8" = 1'-0"

REVISIONS	BY
1 7/26/19 PERMIT	JJS
REVIEW COMMENTS	

Professional Certification
"I certify that these documents were prepared or approved by me, and that I am duly licensed architect under the laws of the State of Maryland, license number 2002 A, expiration date February 25, 2020."

Lorien Nursing - Elkridge Addition

7615 Washington Blvd
Elkridge, Maryland 21075

SECOND FLOOR DEMOLITION PLAN

DATE	April 4, 2019
SCALE	1/8" = 1'-0"
DRAWN	
JOB	JOB NUMBER
SHEET	D1.3
OF	SHEETS