PARTITION TYPES KEYED INTO PLAN

GENERAL NOTES:
1. ALL EXTERIOR DOORS TO HAVE METAL THRESHOLDS ≤ 1/2" MAX. HEIGHT
2. SEE FOOD SERVICE DRAWINGS FOR SERVING PANTRY, BAR COOLER AND DRY STORAGE LAYOUTS.
3. 1/2" x 12" TEMPERED GLASS SHELVES @ 12" O.C., BRACKETS MOUNTED TO HOLLOW METAL WINDOW FRAME
4. SLIDING 42" W X 84" H "BARN" DOORS AT 36" W X 42" H PASS THRU OPENINGS WITH SOLID SURFACE SILLS @ 30" AFF
5. PARTITION TO BE 6'-8" HIGH WOOD 3/4" STAINED WOOD CAP, SEE DETAIL 3 / A5.2
6. ALL FURNISHING AND EQUIPMENT TO BE BY OWNER (NIC)

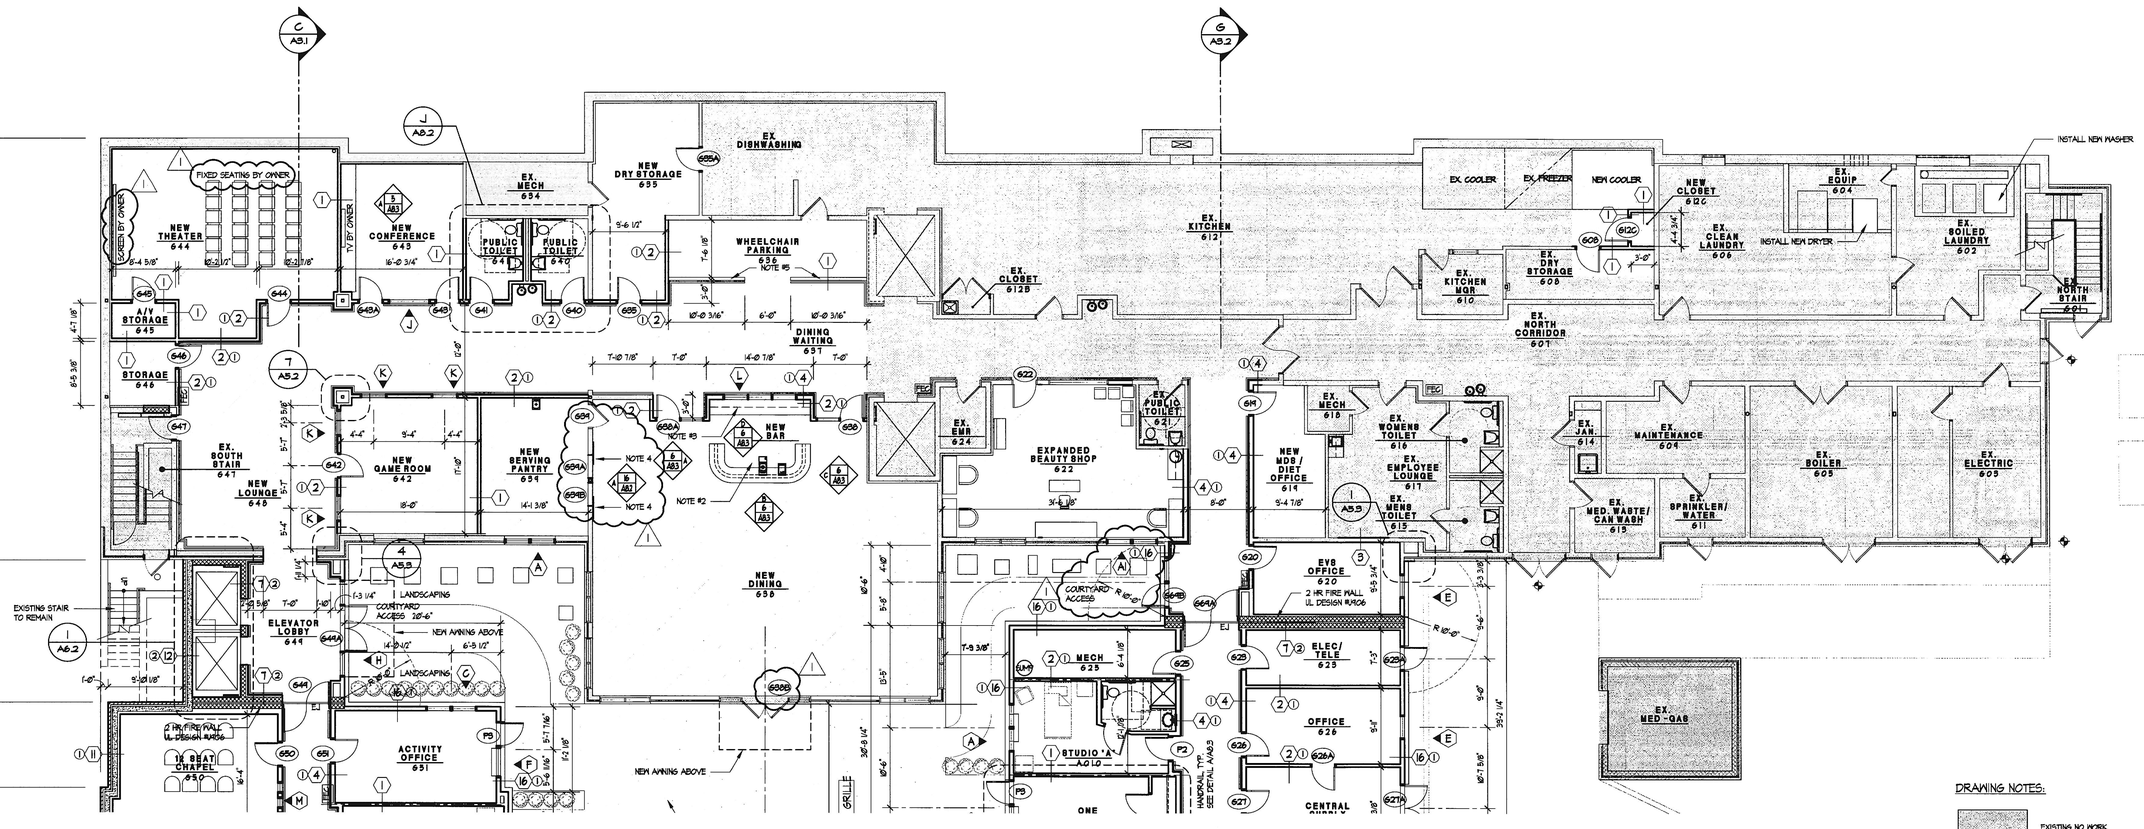

DRAWING NOTES:

EXISTING NO WORK

EXISTING - RENOVATION

SCALE: 1/8" = 1'-0"

KEY PLAN
1/64" = 1'-0"

REVISIONS	BY
1 7/2/19 PERMIT	JJS
REVIEW COMMENTS	

BOARD OF EXAMINERS FOR ARCHITECTS 2002-A STATE OF MARYLAND

Professional Certification
"I certify that these documents were prepared or approved by me, and that I am duly licensed architect under the laws of the State of Maryland, license number 2002 A, expiration date February 25, 2020."

Lorien Nursing – Elkridge Addition

7615 Washington Blvd
Elkridge, Maryland 21075

GROUND FLOOR NEW WORK PLAN

DATE	April 4, 2019
SCALE	1/8" = 1'-0"
DRAWN	
JOB	
SHEET	A1.1
OF	SHEETS