DRAWING NOTES:
1. EQUIPMENT IN PHYSICAL THERAPY TO BE BY OWNER
2. EXISTING CASEWORK TO REMAIN
3. CASEWORK BY OWNER
4. ALL FURNISHINGS AND EQUIPMENT BY OWNER (N.I.C.)
5. EXISTING CASEWORK TO REMAIN

REVISIONS	BY
1 7/26/19 PERMIT	JJS
REVIEW COMMENTS	

BOARD OF EXAMINERS FOR ARCHITECTS 2002-R STATE OF MARYLAND

Professional Certification
"I certify that these documents were prepared or approved by me, and that I am duly licensed architect under the laws of the State of Maryland, license number 2002 A, expiration date February 25, 2020."

Lorien Nursing – Elkridge Addition

7615 Washington Blvd
Elkridge, Maryland 21075

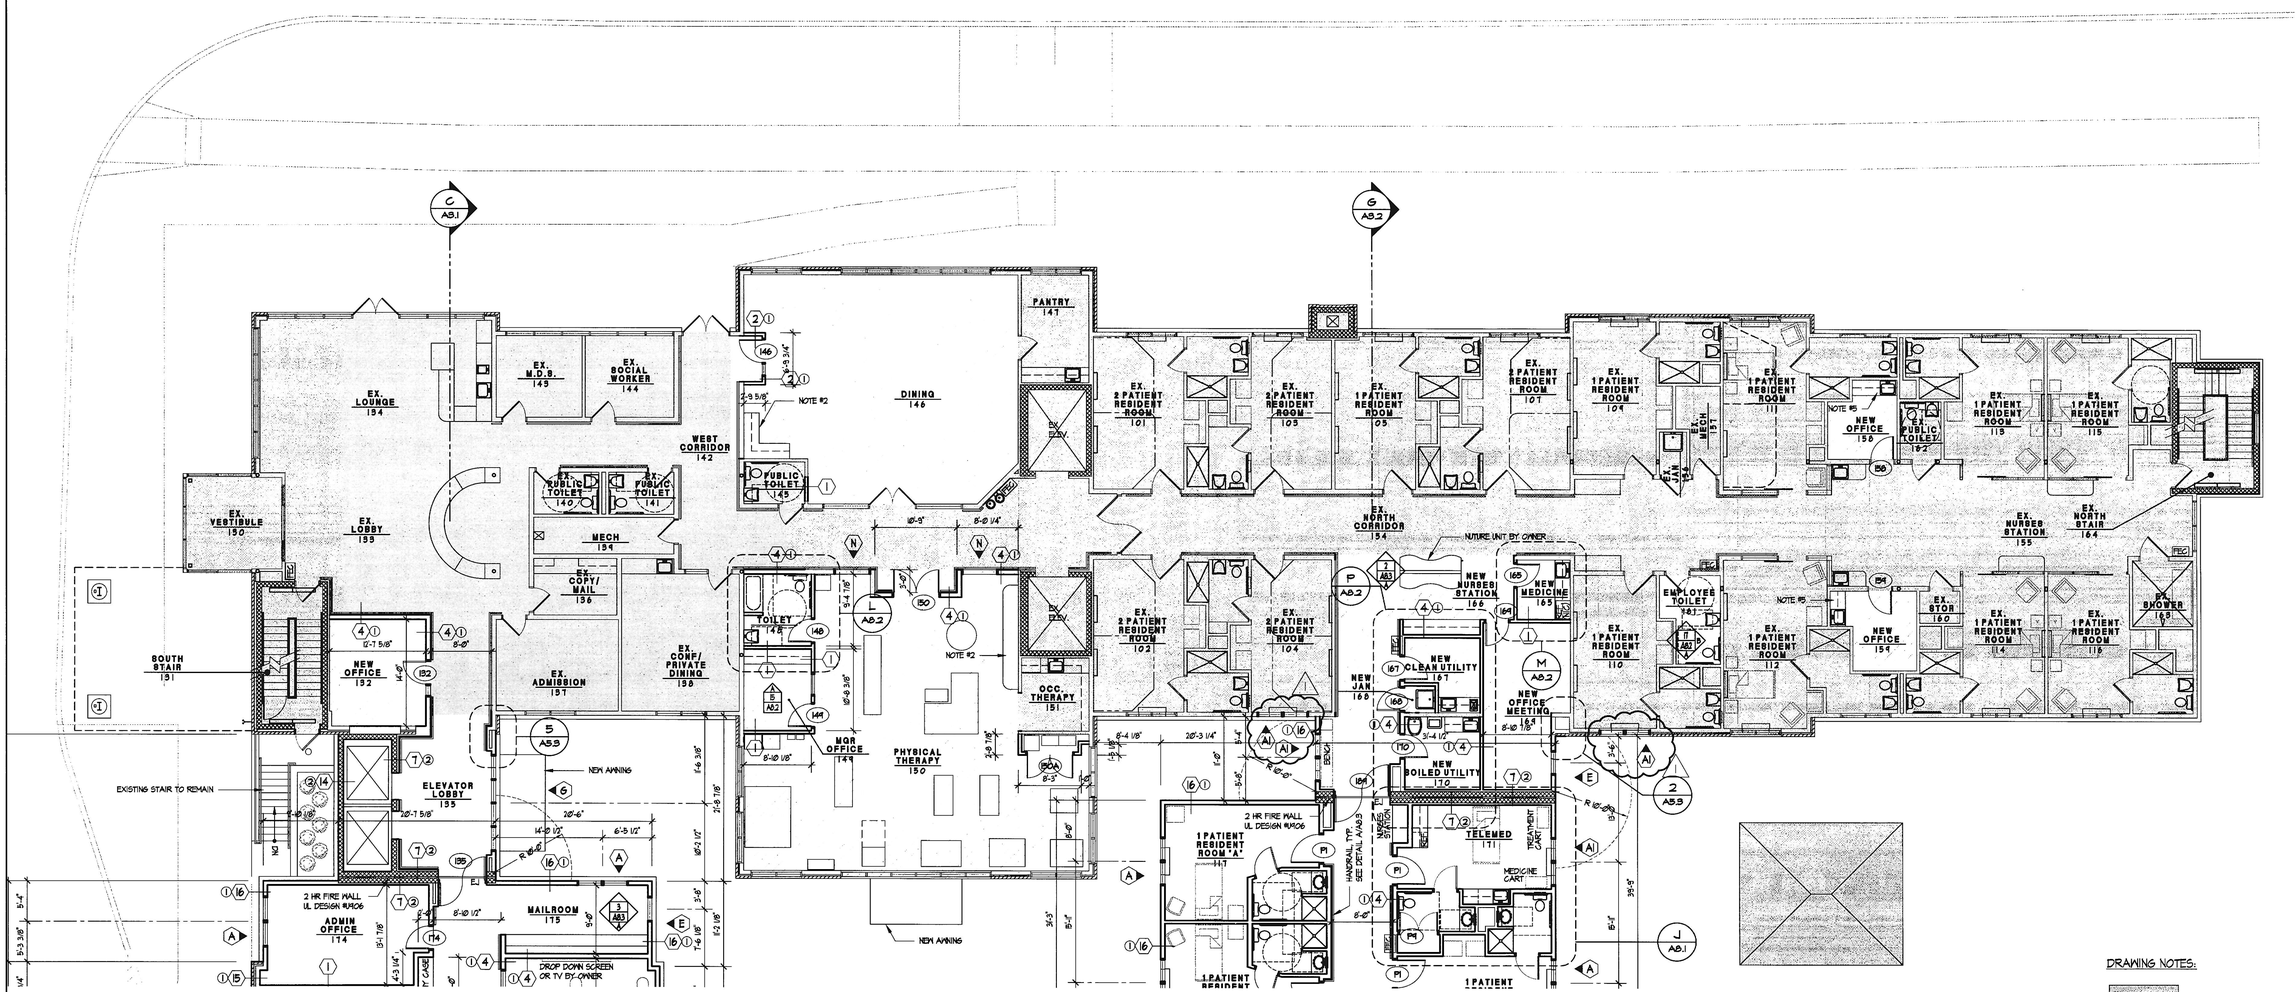

DRAWING NOTES:

EXISTING NO WORK

EXISTING - RENOVATION

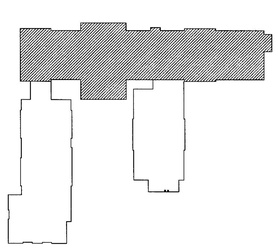

KEY PLAN
1/64" = 1'-0"

SCALE: 1/8" = 1'-0"

FIRST FLOOR NEW WORK PLAN

DATE	April 4, 2019
SCALE	1/8" = 1'-0"
DRAWN	
JOB	
SHEET	A1.3
OF	SHEETS