



A ASSISTED LIVING WING - SOUTH ELEVATION
A2.1 3/8"2" = 1'-0"

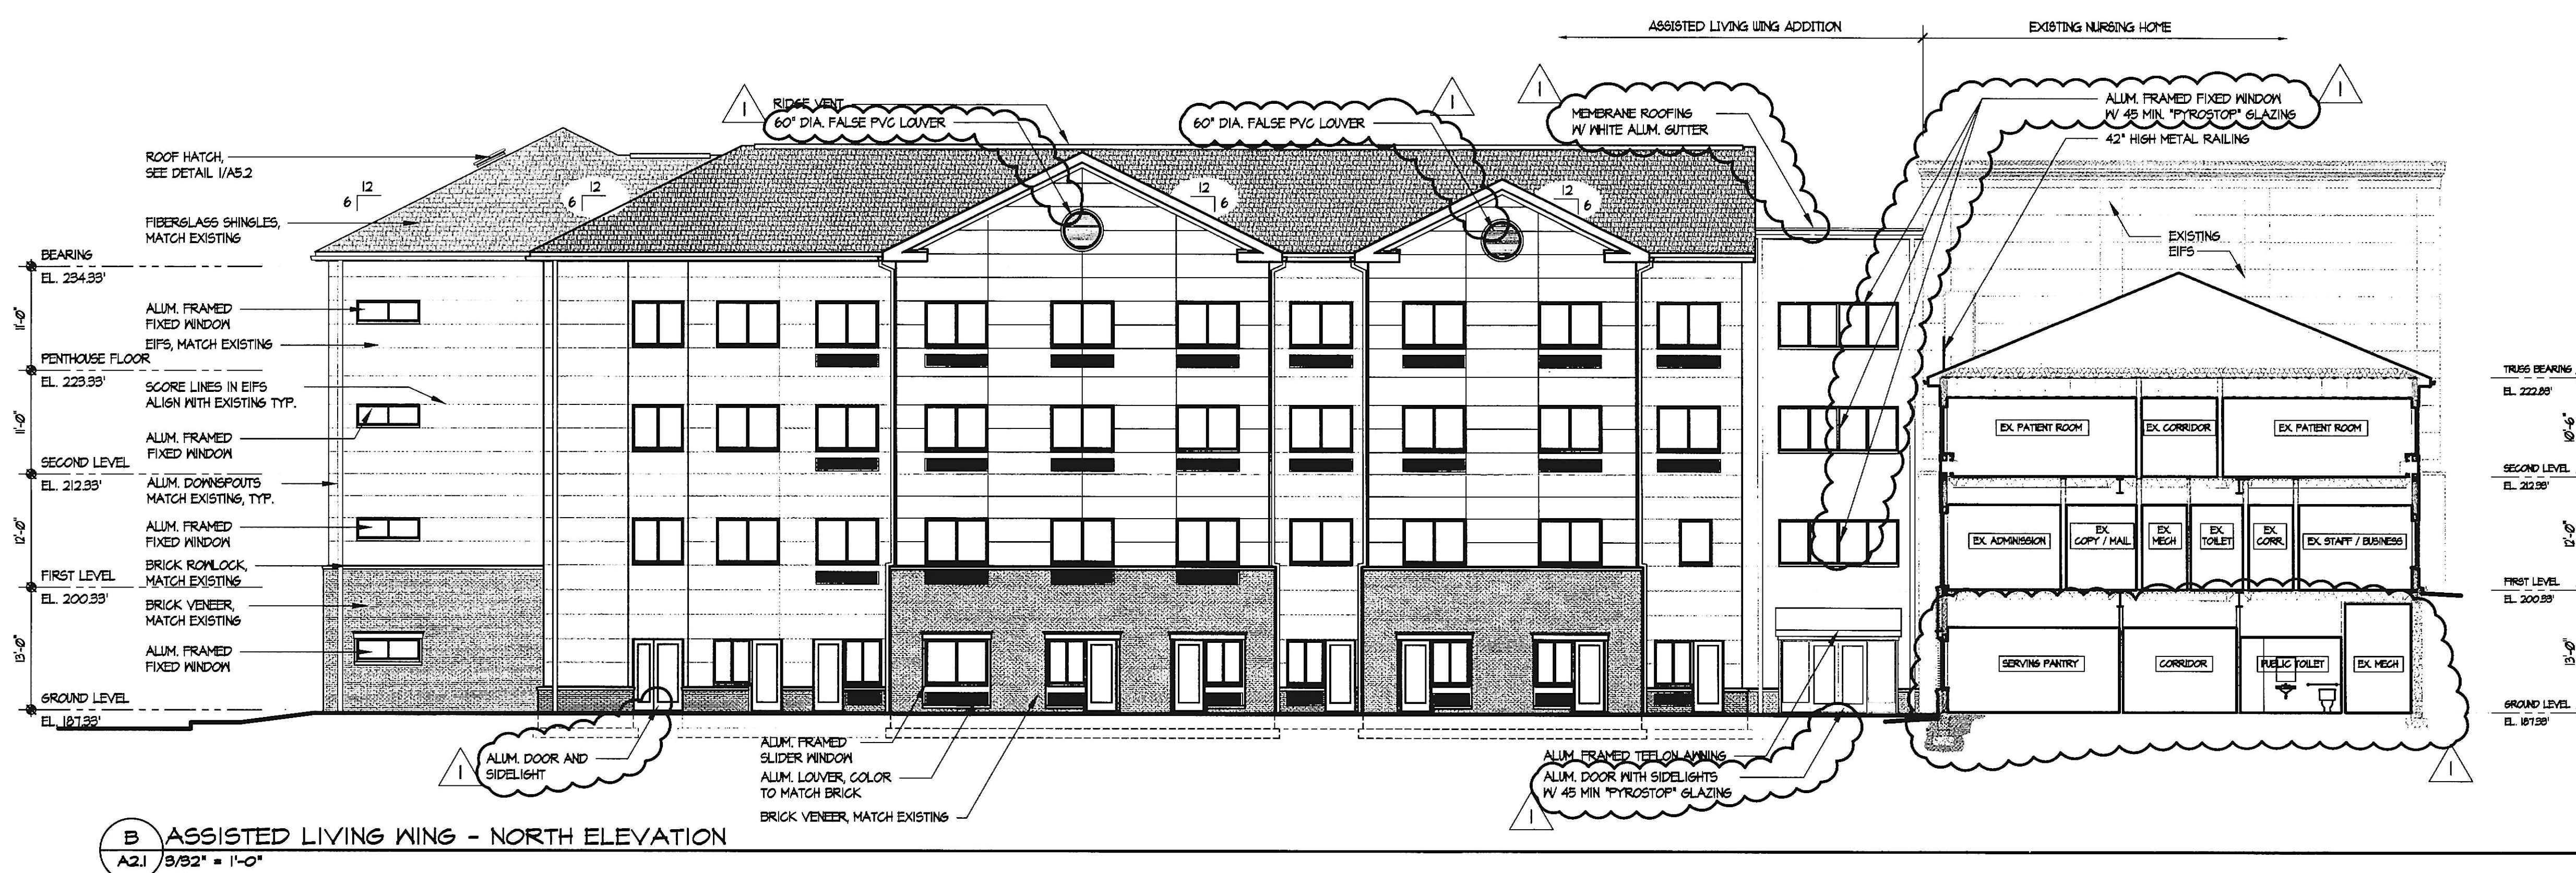

B ASSISTED LIVING WING - NORTH ELEVATION
A2.1 3/8"2" = 1'-0"

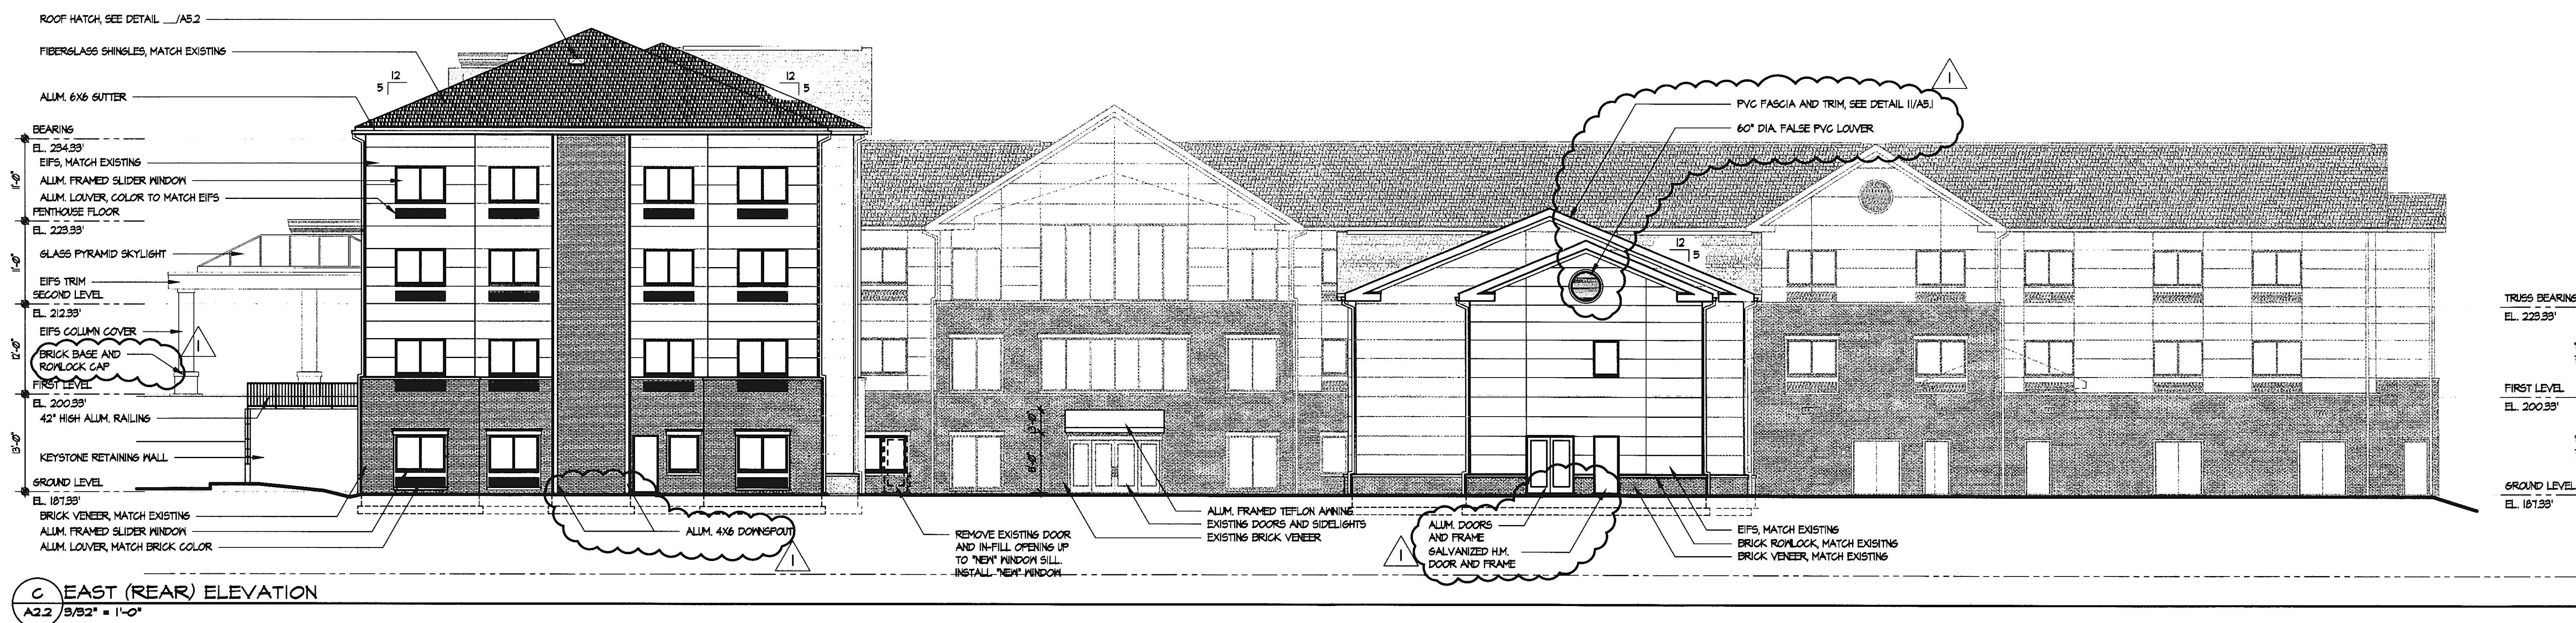

C EAST (REAR) ELEVATION
A2.2 3/8"2" = 1'-0"

DRAWINGS NOTES:

- EIFS TO MATCH EXISTING
- SCORES LINE EIFS TO ALIGN WITH EXISTING, TYP.
- WINDOWS TO MATCH EXISTING
- ALUMINUM LOUVERS TO MATCH EXISTING, WHEN INSTALLED IN BRICK, MATCH COLOR OF BRICK

REVISIONS	BY

1/26/14 PERMIT JLB
REVIEW COMMENTS

Professional Certification I certify that these documents were prepared or approved by me, and that I am duly licensed architect under the laws of the State of Maryland, license number 20024, expiration date February 28, 2020.

Lorien Nursing - Elkridge Addition
 7615 Washington Blvd
 Elkridge, Maryland 21075

ELEVATIONS

DATE: April 4, 2019
 SCALE: 3/32" = 1'-0"
 DRAWN: [Blank]
 JOB: [Blank]
 SHEET: **A2.1**
 OF SHEETS