


D A3.2 BUILDING SECTION - ASSISTED LIVING WING
1/8" = 1'-0"

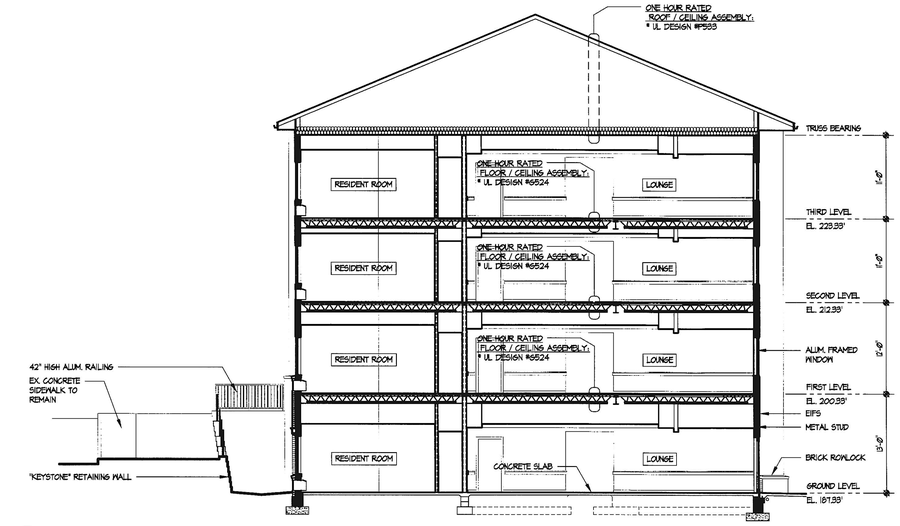


E A3.2 BUILDING SECTION - NURSING WING
1/8" = 1'-0"




F A3.2 BUILDING SECTION - NURSING WING
1/8" = 1'-0"

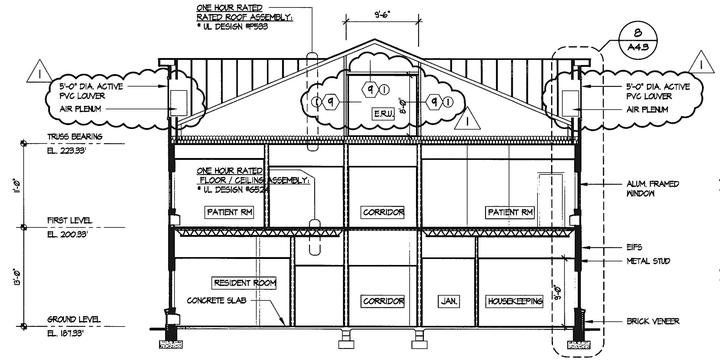


G A3.2 BUILDING SECTION - NURSING WING
1/8" = 1'-0"

| REVISIONS | BY |
|---|---|
| | |
| | |
| | |
| 1 7/26/19 PERMIT | JJS |
| REVIEW COMMENTS | |

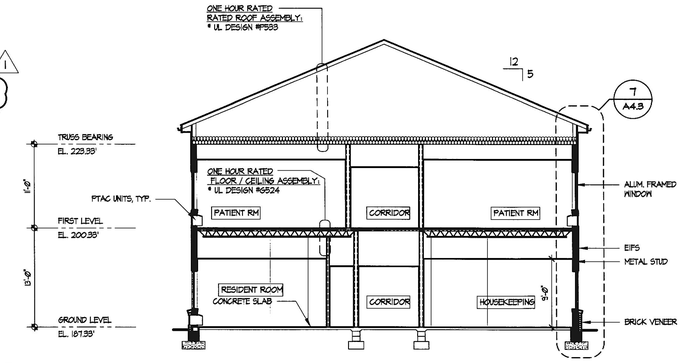BOARD OF EXAMINERS FOR ARCHITECTS REGISTRATION CERTIFICATE
2002-A
STATE OF MARYLAND

Professional Certification
"I certify that these documents were prepared or approved by me, and that I am duly licensed architect under the laws of the State of Maryland, license number 2002 A, expiration date February 25, 2020."
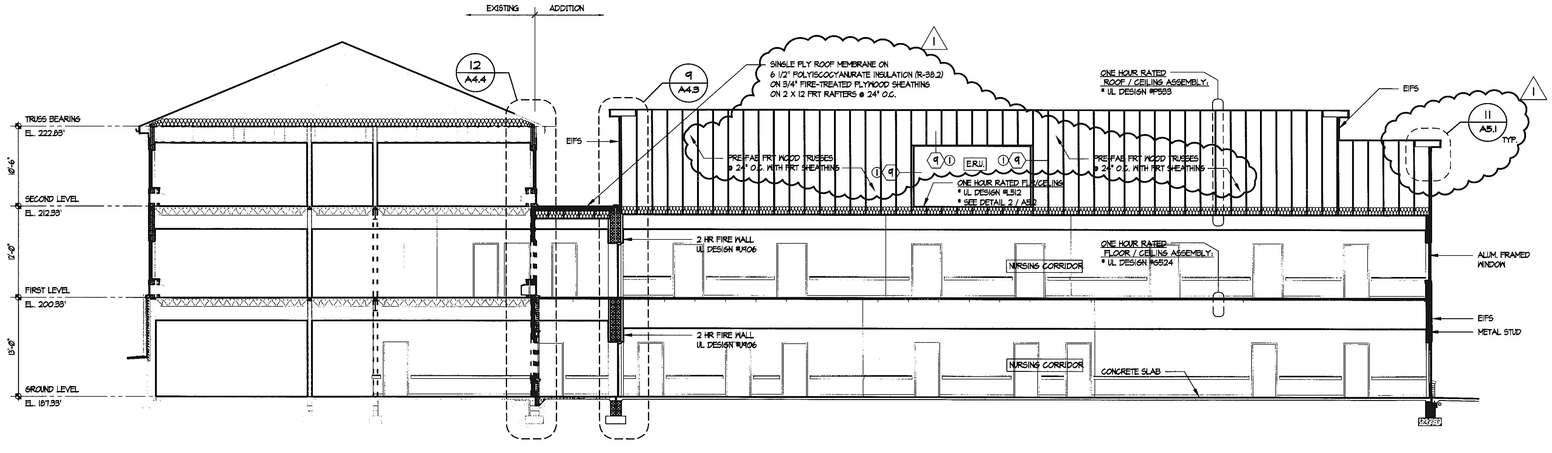
# Lorien Nursing - Elkridge Addition

7615 Washington Blvd.
Elkridge, Maryland 21075

## BUILDING SECTIONS

| | |
|---|---|
| DATE | April 4, 2019 |
| SCALE | 1/8" = 1'-0" |
| DRAWN | |
| JOB | JOB NUMBER |
| SHEET | A3.2 |
| OF | SHEETS |