GENERAL NOTES

1. ALL ELECTRICAL WORK SHALL BE DONE IN ACCORDANCE WITH NEC AND ALL APPLICABLE CODES.
2. PROVIDE TYPEWRITTEN SCHEDULES FOR ALL PANELBOARDS UTILIED AT COMPLETION OF PROECT, INDICATED ACTUAL AS-BUILT CONDITIONS. SCHEDULES SHALL INCLUDE CIRCUIT NUMBER, EQUIPMENT SERVED, BREAKER TRIP SETTING AND WIRE AND CONDUIT SIES.
3. PROVIDE PERMANENT PHENOLIC NAMEPLATES, BLACK W/ WHITE LETTERING, FOR ALL PANELBOARDS, TRANSFORMERS, MECHANICAL EQUIPMENT, PLUMBING EQUIPMENT AND FOR ALL ASSOCIATED DISCONNECT SWITCHES, STARTERS, ETC..
4. COORDINATE EACT LOCATION OF ALL MECHANICAL EQUIPMENT WITH MECHANICAL DRAWINGS.

DRAWING NOTES (#)

1. PROVIDE 0A, 240V, P NFSS IN NEMA R RATED WEATHERPROOF ENCLOSURE.
2. PROVIDE 60A, 240V, P NFSS IN NEMA R RATED WEATHERPROOF ENCLOSURE.
3. MECHANICAL EQUIPMENT PROVIDE WITH INTEGRAL FUSED DISCONNECT SWITCH.

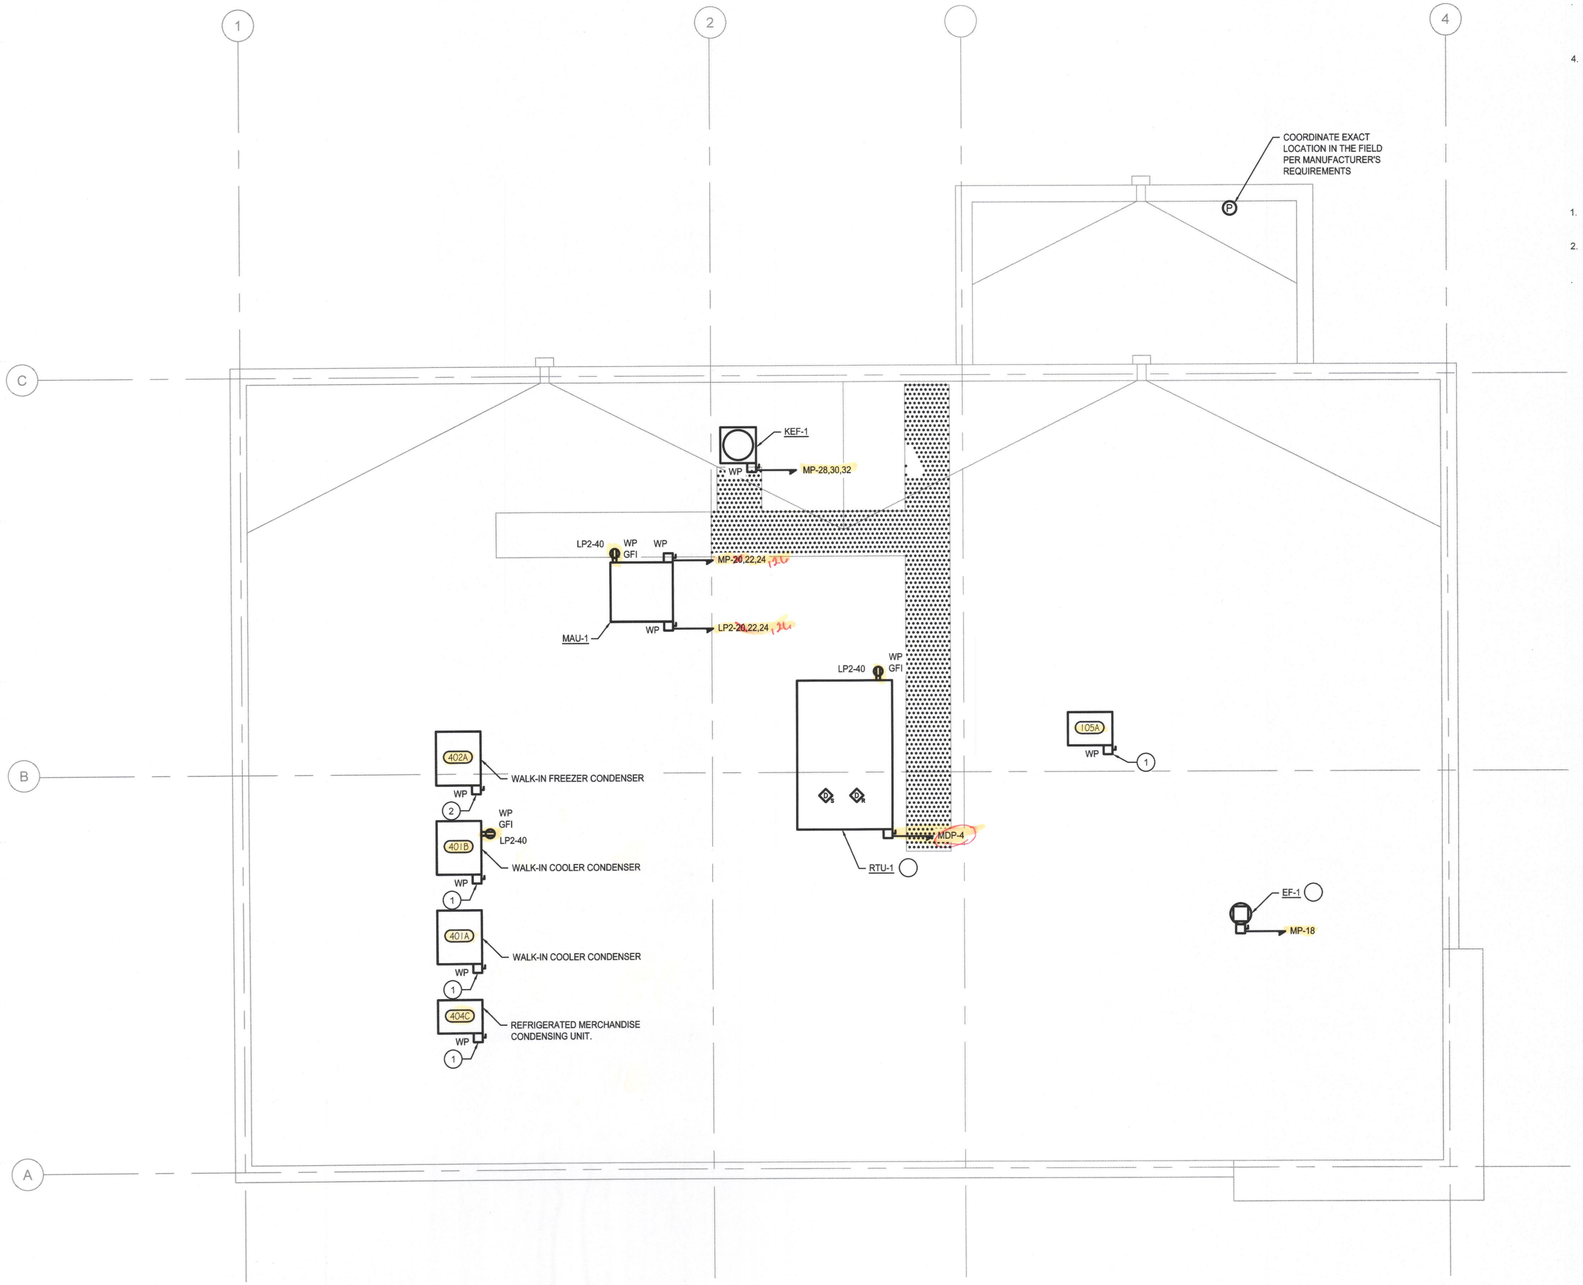

1 ROOF PLAN - ELECTRICAL
S 1/4" 1-0"

L2M
811 Cromwell Park Drive, Suite 113
Cromwell Business Park at BWI
Glen Burnie, Maryland 21061

L2M@L2M.com

Phone 410.863.1302
Fax 410.863.1308

BR
ENGINEERING SERVICES
502 MCr Dr
S M
G Br, Mrd 21061
P 410 761-9600
F 410 761-960
www.rr

w S Mrd
L N. 9920
Er D 17 AN 2019 .

DASH IN
STORE #079
QUARTERFIELD RD - SEVERN, MD

REV. #	ISSUE / DESCRIPTION	DATE

SHEET TITLE:
ROOF PLAN - ELECTRICAL

DRAWING DATE:
01 APRIL 2017

DRAWN BY:	REVIEWED BY:
MLK	BRT

PROJECT #
2889

SHEET #
E-103

FILE NAME:
2889 - E-10 .dwg