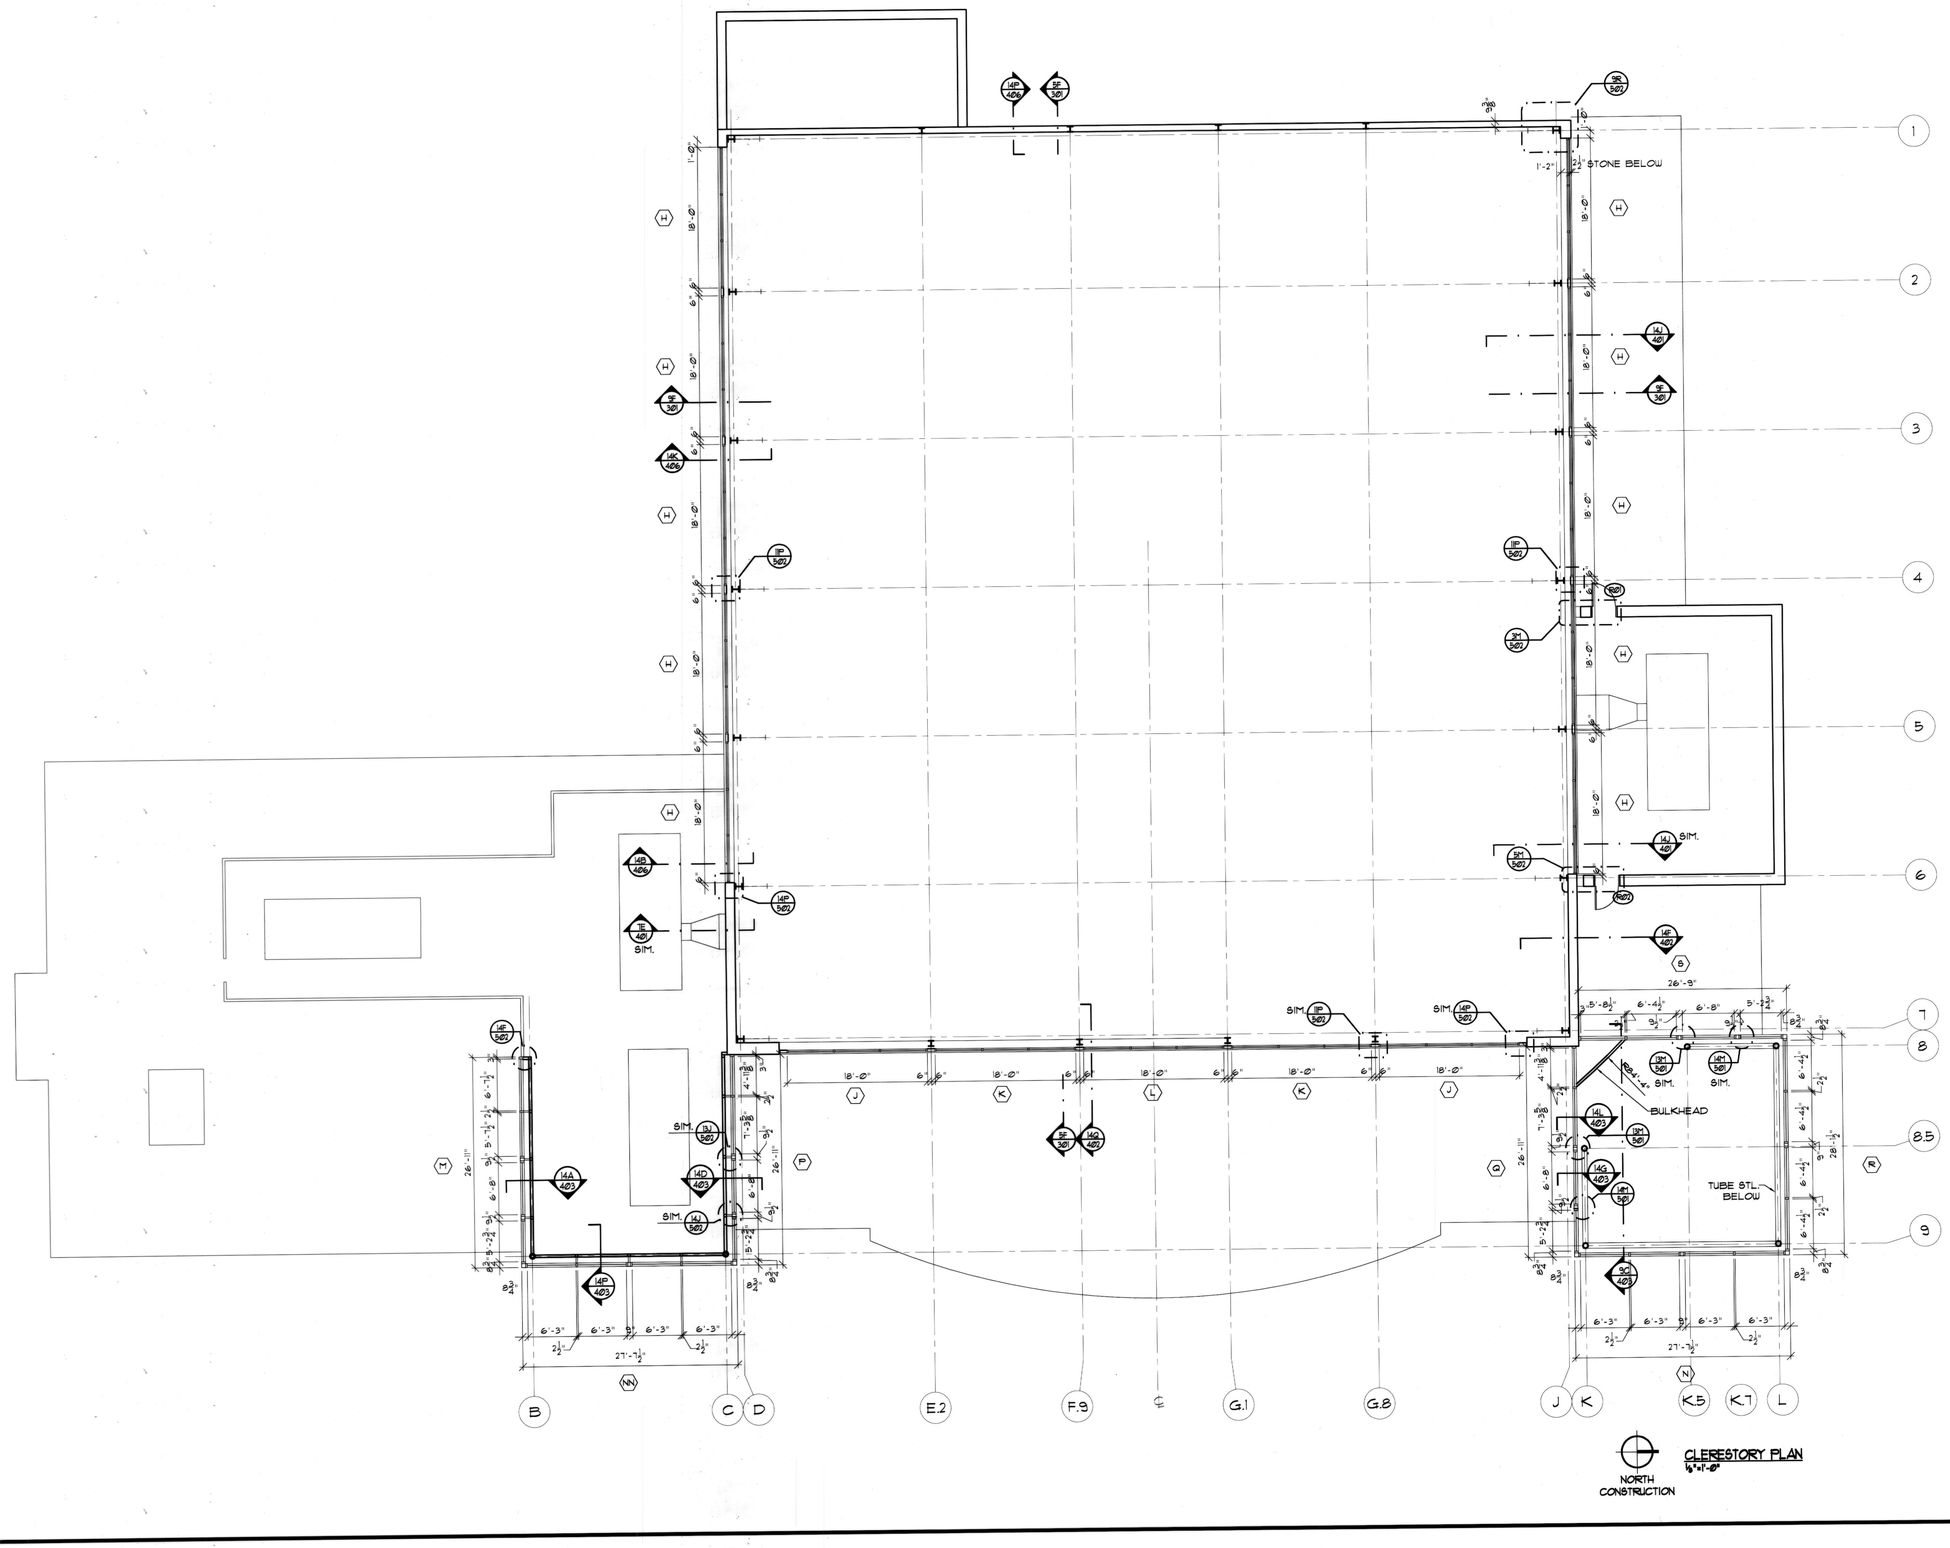


CLERESTORY PLAN
1/8"=1'-0"

NORTH
CONSTRUCTION

RUBELING
& ASSOCIATES, INC.
ARCHITECTURE
INTERIOR DESIGN
401 JEFFERSON AVENUE
TOWSON, MARYLAND 21286-5308
410-337-2886
FAX: 410-337-2974

# SPORT AND FITNESS CENTER
# NOTRE DAME PREPARATORY SCHOOL

815 HAMPTON LANE
TOWSON, MARYLAND 21286

| REVISIONS: | | |
|---|---|---|
| NO. | DESCRIPTION | DATE |
| | RECORD DWGS. | Ø5/Ø5/Ø5 |

LAST REV.:
PROJECT NO.: Ø2-Ø37
DATE: 6-21-Ø3
SCALE: 1/8"=1'-Ø"
TITLE: CLERESTORY WINDOW PLAN
SHEET: A
103

©RUBELING & ASSOCIATES 2003