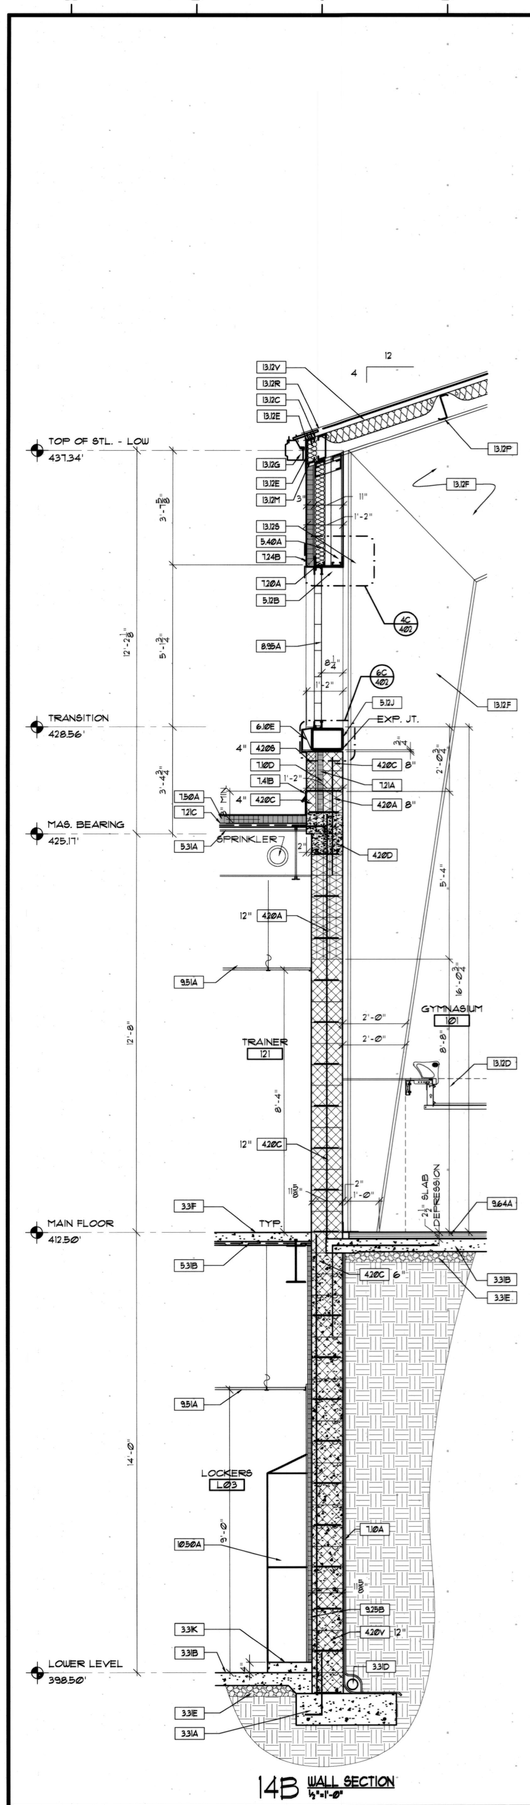

14B WALL SECTION
1/2"=1'-0"

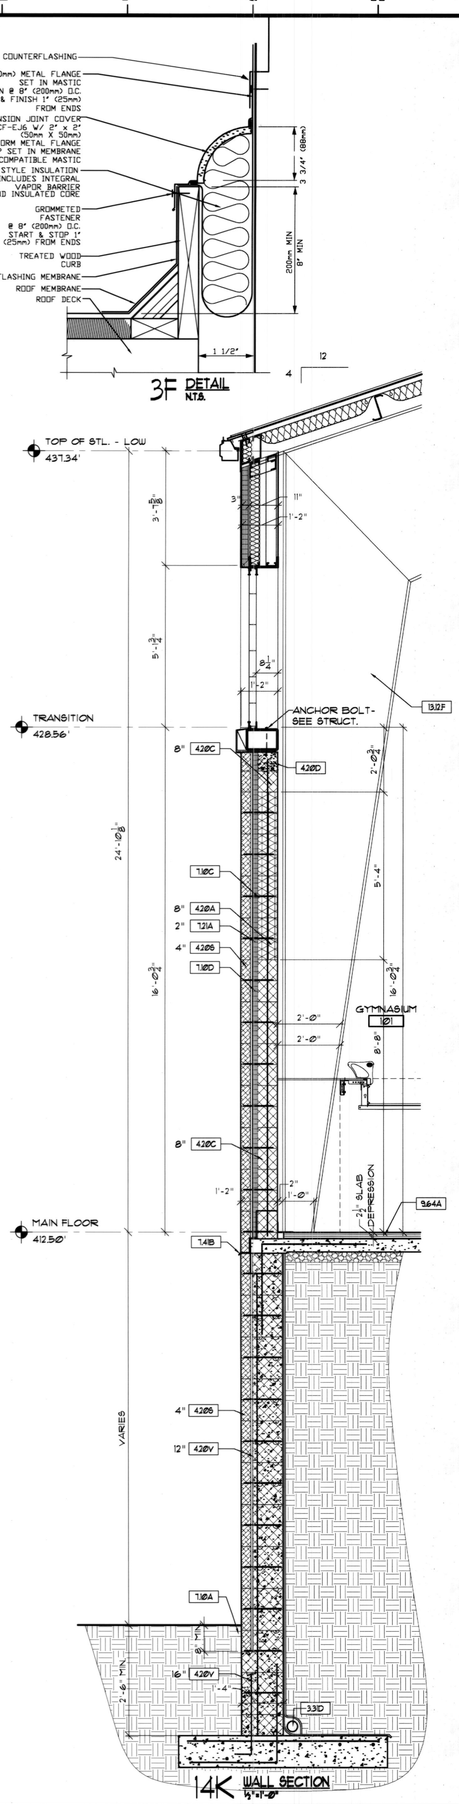

14K WALL SECTION
1/2"=1'-0"

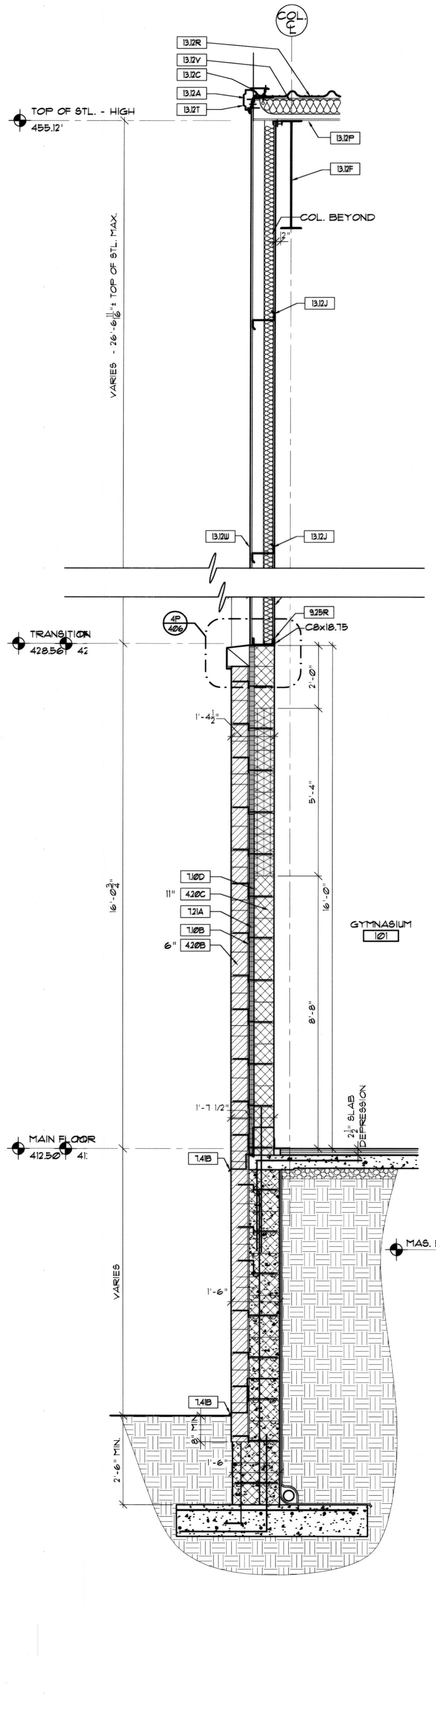

13P DETAIL
1"=1'-0"

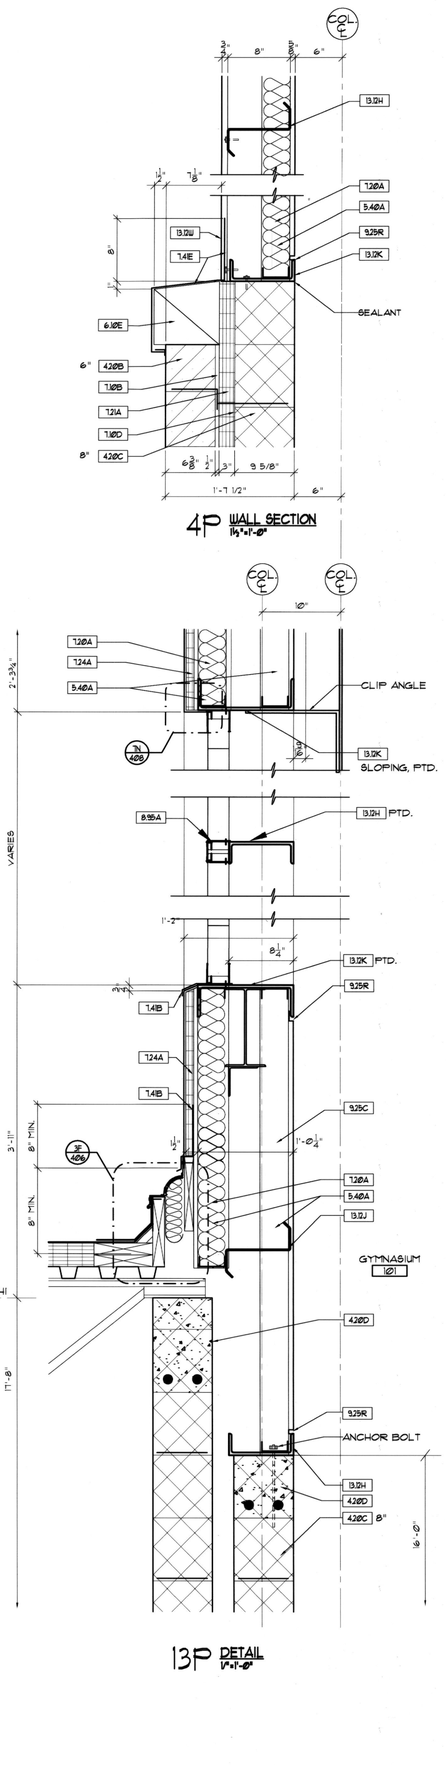

4P WALL SECTION
1/2"=1'-0"

DRAWING NOTES

3.3A	CONCRETE FOOTING. SEE STRUCT. DWGS.
3.3B	5" CONCRETE SLAB ON GRADE w/ 6x6-W2.9 WWF.S WWM. ON VAPOR BARRIER. SEE STRUCT. DWGS.
3.3C	TURNED DOWN CONC. SLAB - SEE STRUCT. DWGS.
3.3D	4" PERFORATED CONT. DRAIN - TIE INTO STORMDRAIN - SEE CIVIL DWGS.
3.3E	4" GRAVEL w/ 6 MIL. VAPOR BARRIER
3.3F	3½" LIGHTWEIGHT CONC. SLAB w/ 6x6-W2.1xW2.1 WWM. AND 1½" COMP. METAL DECK - SEE STRUCT. DWGS.
3.3H	THICKENED SLAB - SEE STRUCT. DWGS.
3.3J	2'-Ø" x ½" S.S. DOWEL
3.3K	CONC. CURB
3.3L	CONC. WALK - SEE CIVIL DWGS.
3.3M	ISOLATION JOINT FILLER STRIP
3.4A	PRECAST CONC. HEAD
3.4B	PRECAST CONC. SILL
4.20A	ACOUSTIC CMU w/JOINT REINFORCING 16" O.C. - SEE PATTERN A#0-**
4.20B	BUTLER STONE w/VENEER ANCHORS 16" EACH WAY
4.20C	CMU w/JOINT REINFORCING 16" O.C.
4.20D	BOND BEAM, SEE STRUCT. DWGS.
4.20E	REINF. CMU WALL - SEE STRUCT.
4.20S	SPLITFACE CMU w/VENEER ANCHORS 16" EACH WAY
4.20V	"IVANY" BLOCK CMU w/TRUSS-TYPE REINF. 16" O.C. MAX VERTICALLY, AND HORZ. BARS - SEE STRUCT. DWGS.
4.20U	"IVANY" SPLITFACE BLOCK w/TRUSS-TYPE REINF. 16" O.C. MAX VERTICALLY, AND HORZ. BARS - SEE STRUCT. DWGS.
5.10A	BEAM - SEE STRUCT. DWGS.
5.10B	HOIST BEAM - SEE STRUCT. DWGS.
5.12A	HAT CHANNEL, 16"O.C.
5.12B	ANGLE - SEE STRUCT. DWGS
5.12C	LINTEL. PTD. - SEE STRUCT. DWGS
5.12D	CHANNEL, PTD.
5.12E	3⅛" KICKER, 4'-Ø" O.C.
5.12G	3½"x3½"x¼" STEEL SILL ANGLE - COORD. W/ ELEVATOR MANUFACTURE
5.12H	STEEL LADDER
5.12J	TUBE STEEL - SEE STRUCT. DWGS
5.12K	3½" x 4½" L.L.V. ANGLE
5.20A	METAL JOIST - SEE STRUCT. DWGS
5.20B	KICKER 4'-Ø" O.C. - SEE STRUCT. DWGS
5.31A	1½" GALV. METAL ROOF DECK
5.31B	2" GALV. COMPOSITE METAL DECK
5.40A	4" 18 GA. METAL STUD, 16" O.C. w/⅝" GWB, PTD.
5.40B	4" 18 GA. METAL STUD, 16" O.C.
5.51A	ALTERNATING TREAD STAIR
5.51A	METAL PAN STAIRS w/CHANNEL STRINGER
5.51B	CHANNEL - SEE STRUCT. DWGS.
5.51C	GUARDRAILS/ HANDRAILS - SEE DETAILS 4C14E/16I
5.51D	STAIR CHANNEL
5.70A	SILL - SEE DOOR SCHEDULE
6.06A	WOOD SILL, STAINED TO MATCH DOORS
6.06B	¾" CDX PLYWOOD
6.06C	½" OSB
6.06D	½" CEMENTITIOUS SHEATHING BOARD
6.10E	WOOD BLOCKING
6.10F	¾" FIRETREATED PLYWOOD
7.10A	WATERPROOFING MEMBRANE & PROTECTION BOARD/FOUNDATION DRAINAGE MATTING
7.10B	½" DRAIN BOARD W/FILTER CLOTH
7.10C	BITUMINOUS DAMPPROOFING
7.10D	BITUMINOUS COATING ON CMU
7.20A	R15 BATT INSULATION w/VAPOR BARRIER
7.21A	2" RIGID INSULATION
7.21B	2" PERIMETER INSULATION
7.21C	ROOF INSULATION 3" MINIMUM
7.24A	EIFS ON 1" RIGID INSULATION ON ½" CEMENTITIOUS SHEATHING BOARD
7.24B	EIFS ON 2½" RIGID INSULATION ON ½" CEMENTITIOUS SHEATHING BOARD
7.41A	PREFINISHED ALUM. PANEL
7.41B	THRU-WALL FLASHING w/WEEPHOLES 2'-Ø" O.C.
7.41C	Ø.4Ø CLEAR ANODIZED ALUMINUM PANEL
7.41D	ALUMINUM SOFFIT
7.41E	CAP FLASHING
7.41F	Ø.4Ø CLEAR ANODIZED ALUMINUM COPING
7.50A	EPDM MEMBRANE ROOFING
7.71A	ALUMINUM COPING - CLEAR ANODIZED
7.72A	ROOF HATCH
8.05A	H.M. FRAME - SEE DOOR SCHEDULE
8.20A	WOOD DOOR - SEE DOOR SCHEDULE
8.40A	ALUM. STOREFRONT
8.40B	ALUM. STOREFRONT DOOR
8.50A	CURTAIN WALL
8.50B	CURTAIN WALL DOOR
8.50C	CURTAIN WALL CAP USED AS TRIM
8.51A	ALUMINUM WINDOW
8.91A	TRANSLUCENT FIBERGLASS SANDWICH PANEL WALL ASSEMBLY
8.99B	ALUMINUM SILL EXTENSION
9.22A	CEILING GRID SYSTEM SHADOW MOLDING
9.25A	⅞" FURRING @ 24" O.C. WITH ⅝" GWB, PTD.
9.25B	1½" RIGID INSULATION WITH 1½" Z-FURRING @ 24" O.C. WITH ⅝" GWB, PTD. - EXTEND INSULATION TO DECK ABOVE
9.25C	⅝" GWB, PTD.
9.25D	3⅝" MET. STUD W/⅝" GWB, PTD.
9.25R	½" REVEAL TRIM, SPACKLE FLUSH
9.51A	SUSPENDED ACOUSTIC CEILING PANEL ASSEMBLY - SEE FINISH SCHEDULE
9.64A	GYMNASIUM FLOATING WOOD ATHLETIC FLOOR SYSTEM W/ FLOOR FANS. PROVIDE VAPOR PROOFING FOAM OVER POLYETHYLENE VAPOR BARRIER ON CONC. 1ST GRADE MAPLE THROUGHOUT, TRANSITIONS TO 3RD GRADE MAPLE BELOW FULLY CLOSED BLEACHERS ONLY - SEE FIN. SCHED. PROVIDE SOLID BLOCKING UNDER OPEN BLEACHERS.
9.64B	ACTIVITY ROOM FLOATING WOOD ATHLETIC FLOOR SYSTEM. PROVIDE VAPOR PROOFING FOAM OVER POLYETHYLENE VAPOR BARRIER ON CONC.
10.50A	LOCKER - SEE FLOOR PLANS
12.48A	MOTORIZED ROLLER SHADE W/ MAN. STD. POCKET FOR MOUNTING
13.12A	GABLE ANGLE
13.12B	CLOSURE PANEL BY BLEACHER MANUFACTURE
13.12C	CLOSURE
13.12D	ELECTRICALLY OPERATED BLEACHERS
13.12E	EAVE STRUT
13.12F	BUILDING FRAME CLEAR SPAN (RF), PTD. P-4 - SEE FINISH SCHED.
13.12G	GUTTER
13.12H	CHANNEL GIRT W/ SAG ROD
13.12J	Z-GIRT
13.12K	CHANNEL GIRT BEAM
13.12M	SIDEWALL FLASHING
13.12P	PURLIN, PTD. P-4 - SEE FINISH SCHED.
13.12R	METAL ROOF W/CLIP SYSTEM
13.12S	STRUCTURAL WITH GIRT & CLIP, PTD. P1 - SEE FINISH SCHED.
13.12T	RAKE TRIM
13.12V	6" FIBER GLASS INSULATION AND VAPOR RETARDER - PERFORATED FOR MAXIMUM ACOUSTIC PERFORMANCE
13.12W	METAL WALL PANELS W/ AGGREGATE PAINT
14.25A	S.S. ELEVATOR DOOR FRAME
15.00A	MECH. SUPPLY VENT - SEE MECH. DWGS.

RUBELING & ASSOCIATES, INC.
ARCHITECTURE
INTERIOR DESIGN
2418 CR. HOWARD AVENUE 02
TOWSON, MARYLAND 21286-5305
410-832-2626
FAX: 410-832-2624

SPORT AND FITNESS CENTER
NOTRE DAME PREPARATORY SCHOOL

815 HAMPTON LANE
TOWSON, MARYLAND 21286

REVISIONS:		
NO.	DESCRIPTION	DATE
	RECORD DWGS.	05/05/05

LAST REV.:
PROJECT NO.: 02-037
DATE: 6-21-03
SCALE: 1/8"=1'-0"
TITLE: WALL SECTIONS

SHEET: A
406

©RUBELING & ASSOCIATES 2003