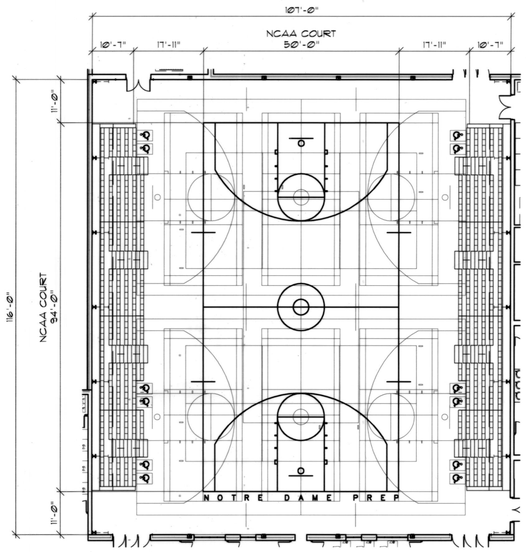

NORTH CONSTRUCTION

GYMNASIUM - NCAA BASKETBALL COURT

1/16=1'-0"

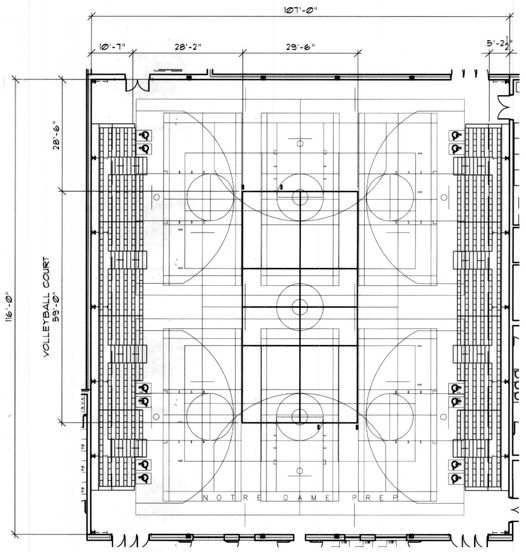

NORTH CONSTRUCTION

GYMNASIUM - NCAA VOLLEYBALL COURT

1/16=1'-0"

NOTE: INSTALL FLOOR INSERTS THIS COURT LAYOUT.

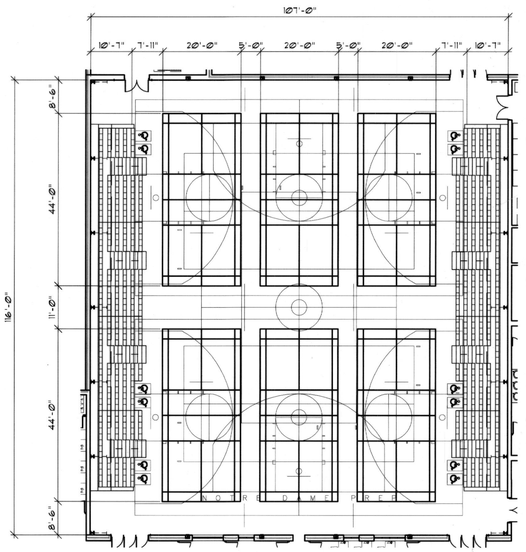

NORTH CONSTRUCTION

GYMNASIUM - BADMINTON

1/16=1'-0"

NOTE: INSTALL FLOOR INSERTS THIS COURT LAYOUT.

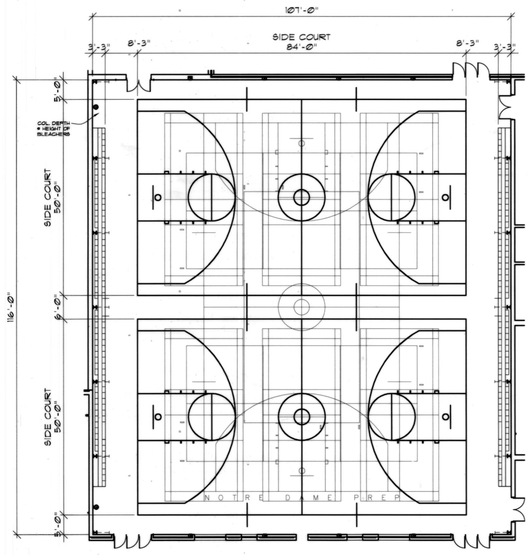

NORTH CONSTRUCTION

GYMNASIUM - BASKETBALL SIDE COURTS

1/16=1'-0"

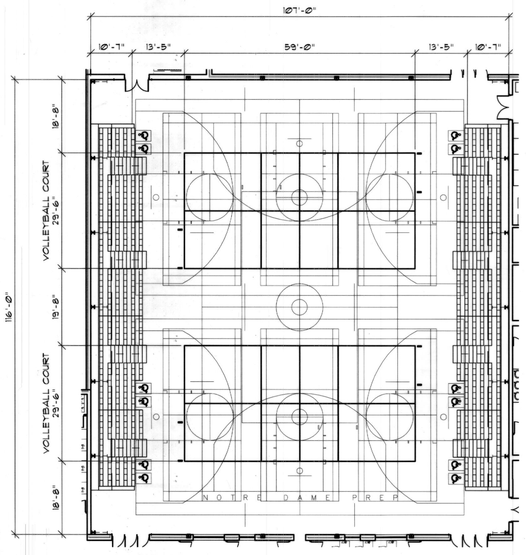

NORTH CONSTRUCTION

GYMNASIUM - VOLLEYBALL SIDE COURTS

1/16=1'-0"

NOTE: INSTALL FLOOR INSERTS THIS COURT LAYOUT.

NDP BLAZERS

11Q CONCEPT FOR CENTER CIRCLE LOGO

1/2"=1'-0"

GENERAL NOTES

1.0 SEE 11Q/A906 FOR CENTER CIRCLE LOGO. LOGO IS TO HAVE 3 COLORS.

2.0 ALL COURT LAYOUT LINES ARE TO BE 2" MAX. THICK. THERE ARE TO BE 5 DIFFERENT LINE COLORS, ONE COLOR FOR EACH COURT LAYOUT.

RUBELING & ASSOCIATES, INC.
ARCHITECTURE
INTERIOR DESIGN
401 JEFFERSON AVENUE
TOWSON, MARYLAND 21286-5308
410-337-2866
FAX: 410-337-2974

SPORT AND FITNESS CENTER
NOTRE DAME PREPARATORY SCHOOL

815 HAMPTON LANE
TOWSON, MARYLAND 21286

REVISIONS:		
NO.	DESCRIPTION	DATE
	RECORD DWGS.	09/09/03

LAST REV.:
PROJECT NO.: 02-037
DATE: 6-27-03
SCALE: AS NOTED
TITLE: GYMNSIUM COURT LAYOUTS
SHEET: A
906

©RUBELING & ASSOCIATES 2003